

Name George-H. Doughty

Service No. 1067

Address 64 Taft Avenue

Lexington, Mass.

Location 64 Taft Avenue

Kind of Pipe

Size 6"

Size of Main 8"

~~Repair-Renewal~~—New Service

Location

Date	Material	Amount	Total	Date	Amount
Apr. 28, '47	Labor	59 88		Apr 25 '47	150 00
Apr. 29, '47	"	23 25	83 13	May 22 '47	33 98
	10% Overhead		8 31		116 02
	42' - 6" Sewer Pipe @.24		10 08		
	1 - 6" Y		1 71		
	Joint Compound		2 52		
	1 bag' of Cement		1 05		
	Dynamite 6 lbs. @.21		1 26		
	Exploders 11 @ .11		1 21		
	Compressor 3 hrs. @1.75		5 25		
	Trucking 2 hrs. @.75		1 50		
	Labor		116.02		

TOWN OF LEXINGTON—DEPT. OF PUBLIC WORKS

SEWER DIVISION

DATE

NO.


The undersigned applies for the construction of a particular sewer connecting No. Street and hereby agrees to comply with the Rules and Regulations governing the construction and use of Particular Sewers, as now or at any future time established by the Board of Selectmen.

Am't of estimate \$.....

Am't Paid \$.....

..... Owner

Sketch of Service Here **64**

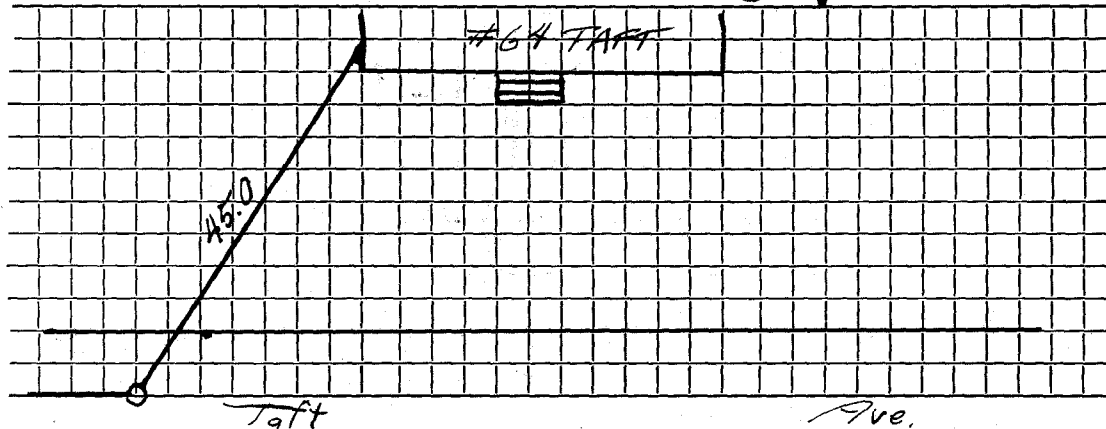

Connection made in Street.

Work completed 19..

Remarks: