

Name **Don Irwin**

Service No. **100**

Address **11 Tarbell Ave.**

Lexington 11 Tarbell Ave. Location

Kind of Pipe

Size **6"**

Size of Main **8"**

~~REPAIR~~ **New Service**

COM. 11-3-52

Location

Date	Material	Amount	Total	Date	Amount
9/16/52	Labor	39 23		7-10-52	Deposited 125 -
	10% Overhead	3 92	43 15	11-5-52	Overfunded (41) P6
	46' - 6" sewer pipe @.342		15 73		83 14
	joint compound		2 76		
	4 hr. town shovel @5.00		20 00		
	2 hr. trucking		<u>1 50</u>		
			83 14		
	Labor			10-9-96	Respond & Measure

TOWN OF LEXINGTON—DEPT. OF PUBLIC WORKS
SEWER DIVISION

DATE.....

NO.


The undersigned applies for the construction of a particular sewer connecting No.....
Street and hereby agrees to comply with the Rules and Regulations governing the construction and use of Particular
Sewers, as now or at any future time established by the Board of Selectmen.

Am't of estimate \$.....

Am't Paid \$.....

..... Owner

Sketch of Service Here

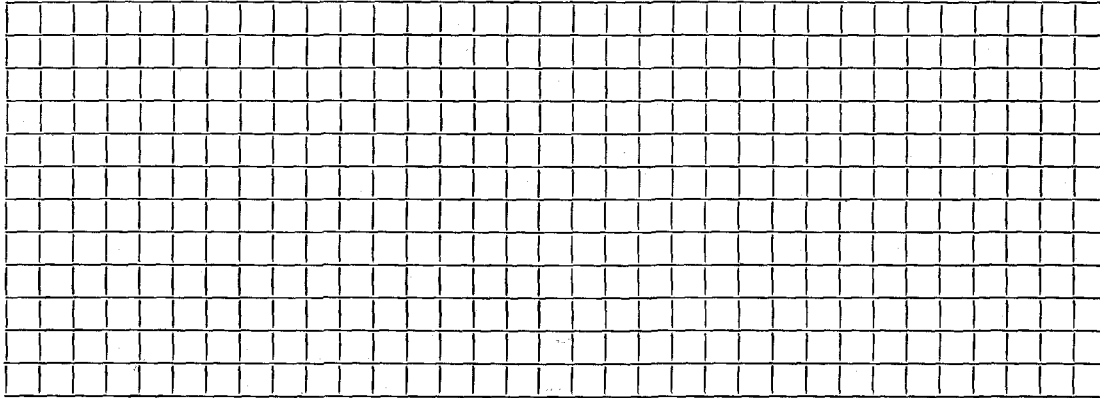

Connection made in.....Street.

Work completed.....19..

Remarks: