

Name Richard Hamilton

Service No. 67

Address 15 Tarbell Avenue

15 Tarbell Ave.

Location

Kind of Pipe

Size 6"

Size of Main 8"

~~REPAIR~~ New Service

Location Comm 7-17-61


Date	Material	Amount	Total	Date	Amount
6-12-61	Labor 70.15			6-2-61	200 00
6-13-61	Labor 8.32	78.47		7-17-61	41 44
	10% O.H.	7.85	86.32		158.56
	53' 6" Transite pipe @.78		41.34		
	1 6" 90° Transite Elbow		5.40		
	3 Hrs. Town Shovel @6.50		19.50		
	2 Hrs. Trucking @3.00		6.00		
			<u>158.56</u>		

DATE _____

TOWN OF LEXINGTON — BOARD OF PUBLIC WORKS

SEWER DIVISION

Sketch of Service Here

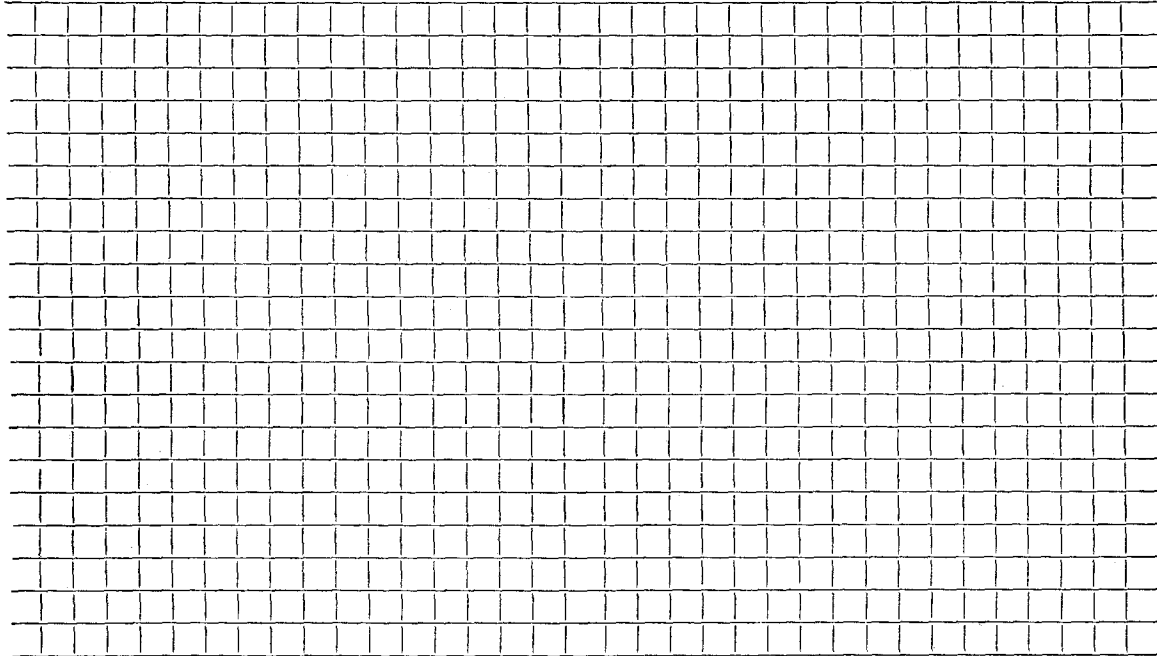

Connection made in Street. Work completed

Remarks:
.....
.....