


DATE _____

TOWN OF LEXINGTON — BOARD OF PUBLIC WORKS

SEWER DIVISION

31 TARBELL

Sketch of Service Here

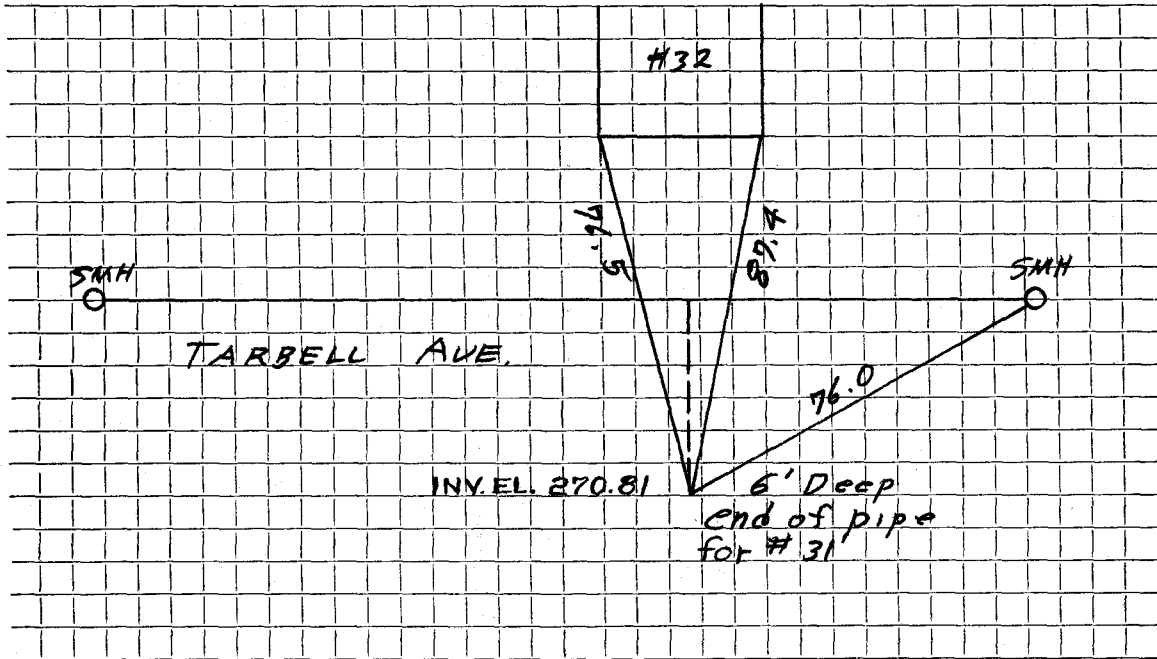

Connection made in Street. Work completed

Remarks:
.....
.....