

Sewer Service Record

Name _____ Service No. _____

Address 32 TARRELL

Location _____

Kind of Pipe SDR35 PVC Size 6" Size of Main _____


Repair - Renewal - New Service _____ Location _____

Date	Material	Amount	Total	Date		Amount
12/13/23	6" SDR35 PVC					
	6" Ferroc					
	6" Cleanout					

Date: 12/13/23

TOWN OF LEXINGTON - BOARD OF PUBLIC WORKS
SEWER DIVISION

SKETCH OF SERVICE HERE

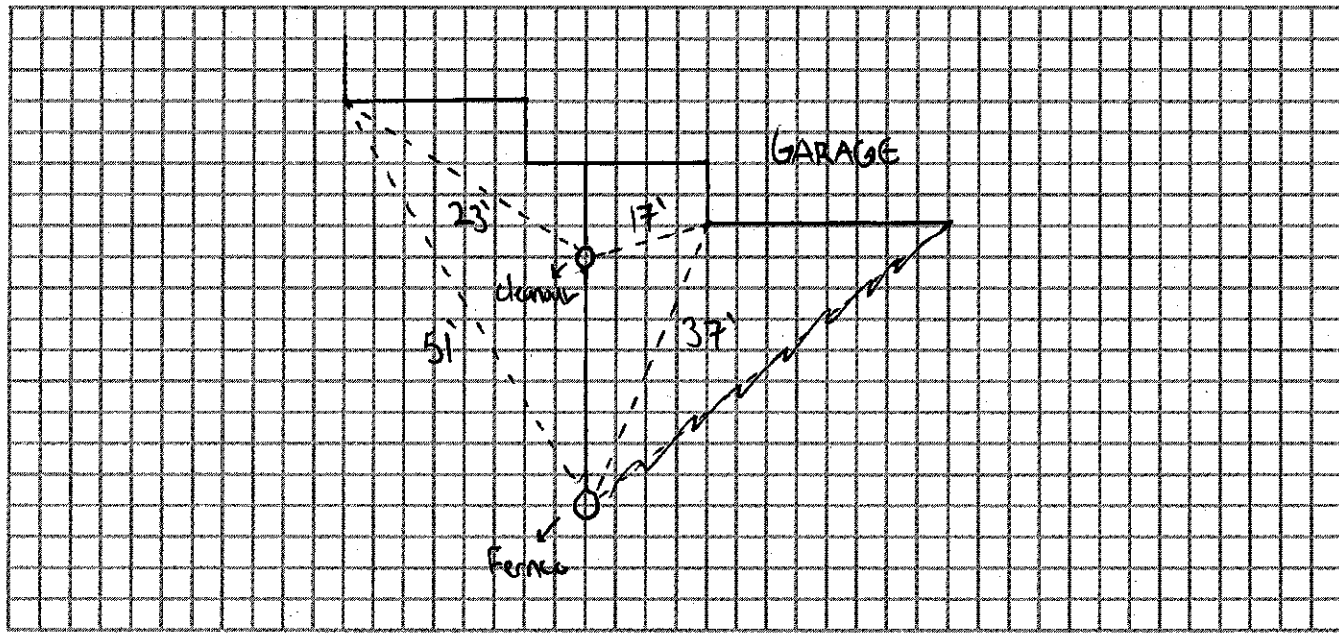

Connection made in:

Street:

Work completed:

Remarks: INSTALLED BY LYNCH DEVELOPMENT