

Name William Domigan

Service No. 121

Address #37 TARBELL AVE.

Lots 184-186

Location

Kind of Pipe

Size 6"

Size of Main 8"

~~Repair Renewal~~ New Service Valeri #1262


Location MAY 27 1969

Date	Material	Amount	Total	Date	Amount
8-20-62	Labor	18.06		<i>11-22-68</i>	<i>47.50</i>
	10% O.H.	1.81	19.87		
	18' 6" Transite pipe @.78		14.04		
	1 90° 6" Elbow		4.09		
	1 hr. Town Shovel @6.50		6.50		
	1 hr. Trucking @3.00		<u>3.00</u>		
	BILL WHEN CONNECTED		47.50		
11-27-68	34' 6" Transite pipe				
	34.6' 4" Cast Iron pipe				
				<i>11-16-74</i>	<i>Solids 3' or 4' out</i>

DATE _____

TOWN OF LEXINGTON — BOARD OF PUBLIC WORKS
SEWER DIVISION

Sketch of Service Here **37**

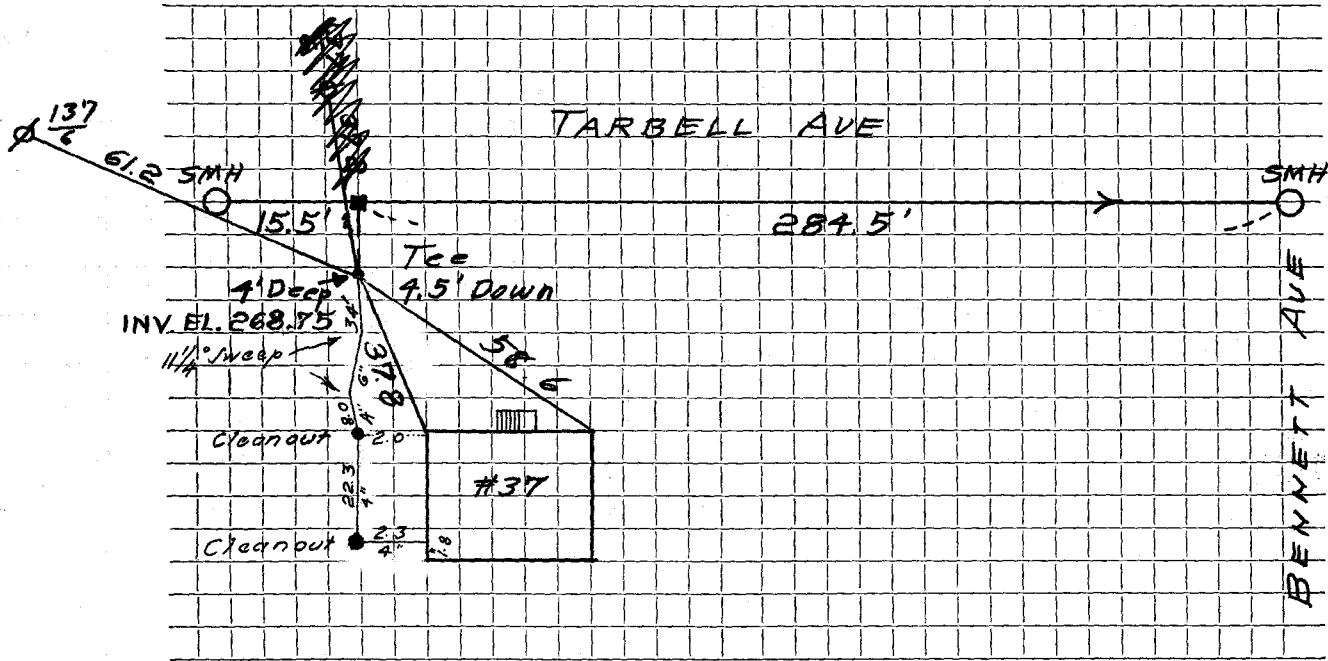

Connection made in Street. Work completed

Remarks:
.....
.....