

Name Robert Ivarson

Service No. 47

Address #38 TARBELL AVE.

Lots 151-153

Location

Kind of Pipe

Size 6"

Size of Main 8"

~~Repair Renewal~~—New Service Valeri #1882

Location JUN 5 1972


Date	Material	Amount	Total	Date	Amount
8-20-62	Labor	18.06		3-8-71	Deposit 47.50
	10% O.H.	1.81	19.87		
	18' 6" Transite pipe @.78		14.04		
	1 90° Transite Elbow		4.09		
	1 hr. Town Shovel @6.50		6.50		
	1 hr. Trucking @3.00		<u>3.00</u>		
	BILL WHEN CONNECTED		47.50		
7/27/71	60' 6" Transite pipe				

DATE _____

TOWN OF LEXINGTON — BOARD OF PUBLIC WORKS

SEWER DIVISION

Sketch of Service Here **38**

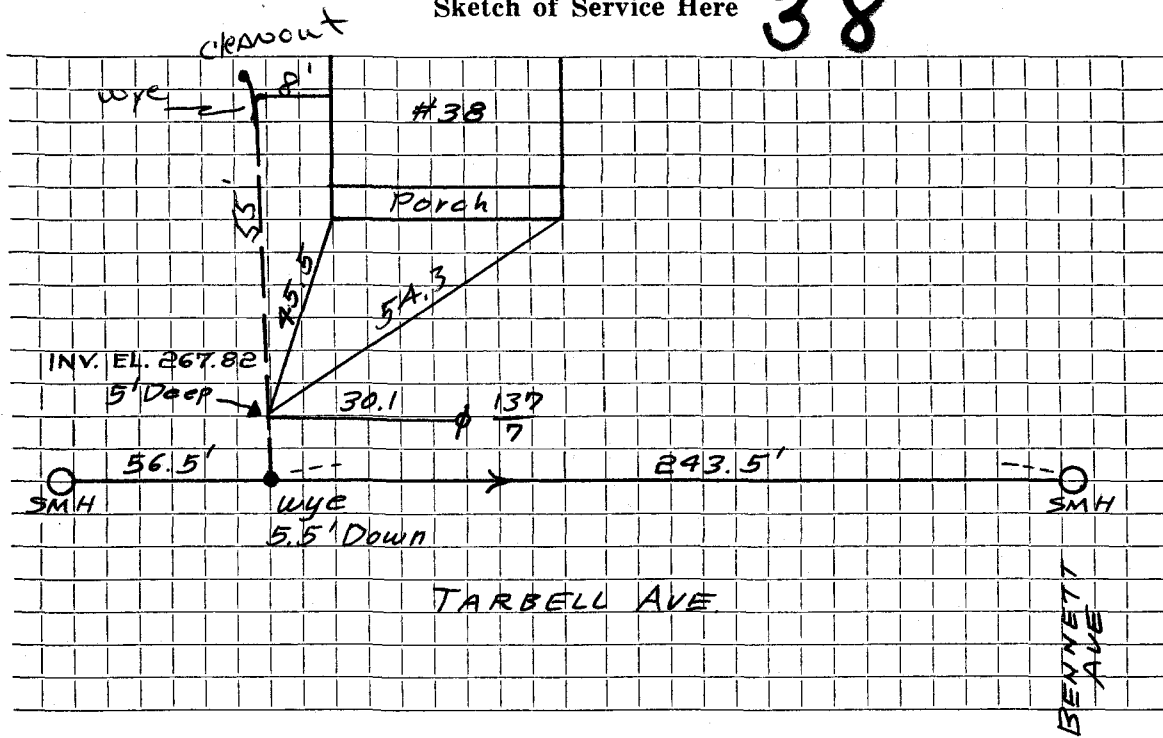

Connection made in Street. Work completed

Remarks:
.....
.....