

Name **Patrick J. Powers**Service No. **118**Address **# 41 TARBELL AVE.**Lots **181-183**

Location

Kind of Pipe

Size **6"**Size of Main **8"**~~Repair Renewal~~ **New Service**Wo # **7498**Location **Comm 10-29-62**


Date	Material	Amount	Total	Date	Amount
8-18-62	Labor	37.59		7-31-62	Deposit 300.00
	10% O.H.	3.76	41.35	10-29-62	Refund 60.53
	20' 6" Transite pipe @.78		15.60		239.47
	1 90° 6" Transite Elbow		4.09		
	2 hrs. Town Shovel @6.50		13.00		
	1 hr. Trucking @3.00		3.00		
	BILL WHEN CONNECTED		77.04		
9-10-62	Labor	74.85			
	10% O.H.	7.49	82.34		
	50' 6" Transite pipe @82		41.00		
	1 11¼° Transite bend		4.09		
	4 Hrs. Town Shovel @6.50		26.00		
	2 Hrs. Trucking @3.00		6.00		
	1 Hr. Compressor @3.00		3.00		
			239.47		

DATE _____

TOWN OF LEXINGTON — BOARD OF PUBLIC WORKS

SEWER DIVISION

Sketch of Service Here **41**

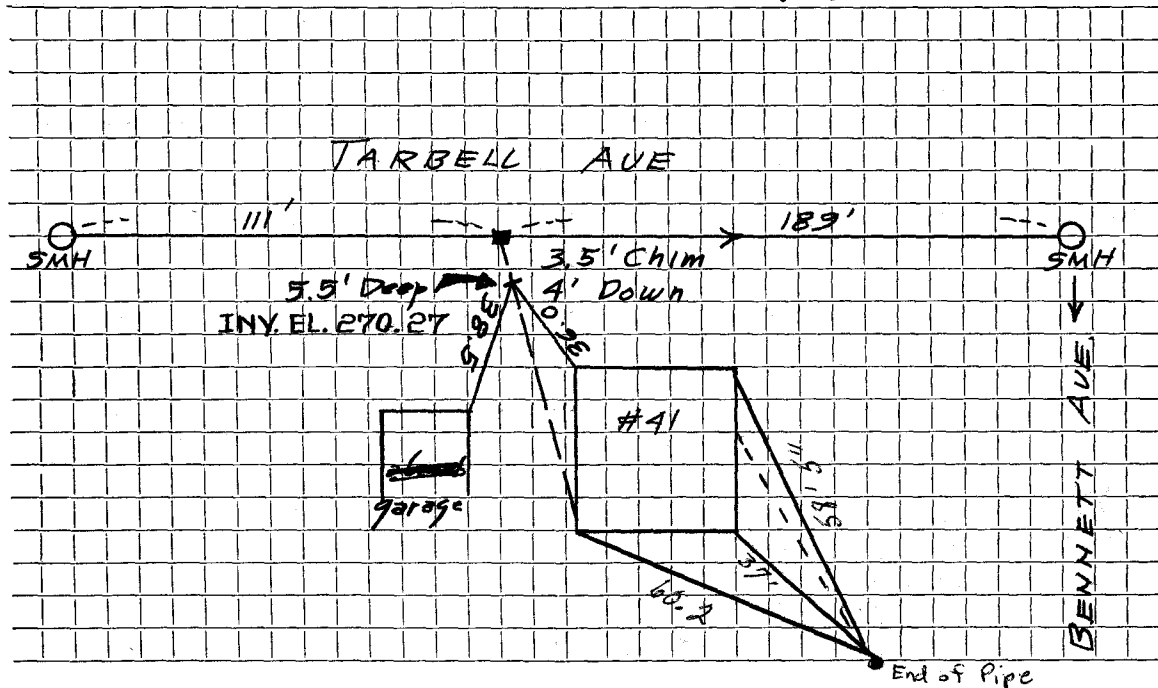

Connection made in Street. Work completed

Remarks:
.....
.....