


DATE 5-19-95

TOWN OF LEXINGTON — BOARD OF PUBLIC WORKS
SEWER DIVISION

Sketch of Service Here **54**

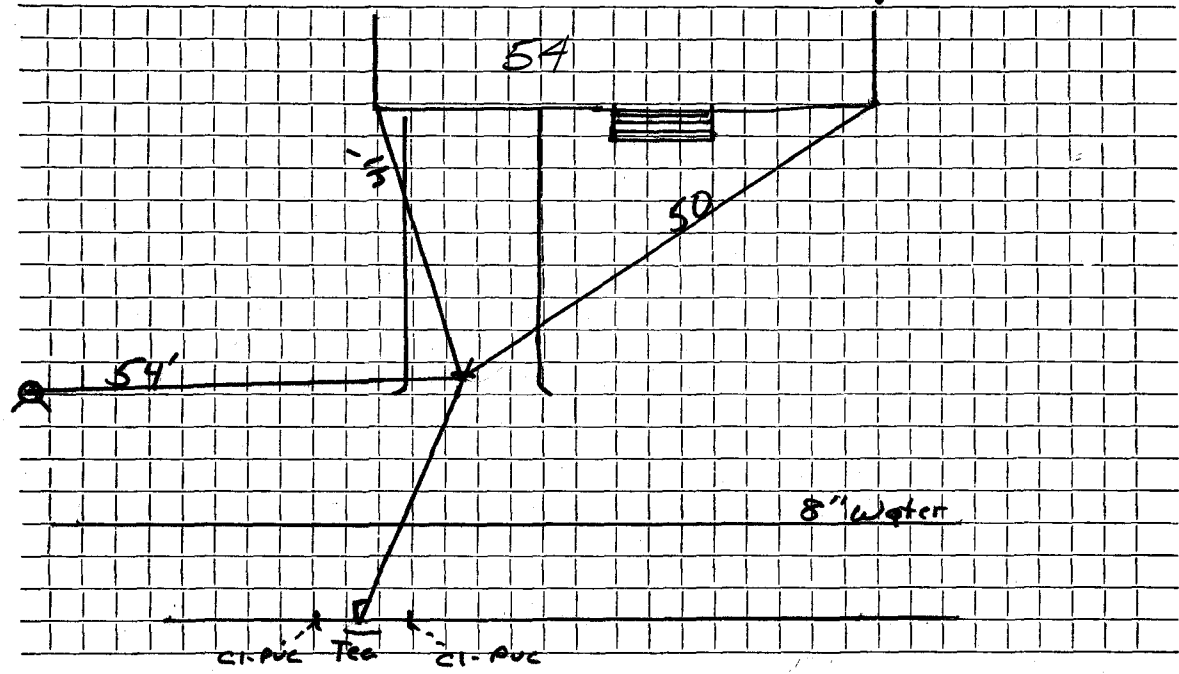

Connection made in Street. Work completed 5-18-95

Remarks:
.....
.....