

Name L. vonia-Holden

Service No. ²⁶

1078

Address 57 Tarbell Avenue

Lexington, Mass.

Location 57 Tarbell Avenue

Kind of Pipe

Size 6"

Size of Main 8"

~~Repair-Renewal~~ New Service

Location

Date		Material	Amount	Total	Date		Amount
June 5,	47	Labor	7 80		June 2 '47	Deposited	90 00
6		"	35 88	43 68	Nov 29 '47	Refunded	30 21
		10% Overhead		4 37			59 79
		32' - 6" Sewer Pipe @.26		8 32			
		Joint Compound		1 92			
		Trucking 2 hrs. @.75		1 50			
				59 79			
		Labor					
		Com 11-24-47					

TOWN OF LEXINGTON—DEPT. OF PUBLIC WORKS

SEWER DIVISION

DATE

NO.


The undersigned applies for the construction of a particular sewer connecting No. Street and hereby agrees to comply with the Rules and Regulations governing the construction and use of Particular Sewers, as now or at any future time established by the Board of Selectmen.

Am't of estimate \$.....

Am't Paid \$.....

..... Owner

Sketch of Service Here **57**

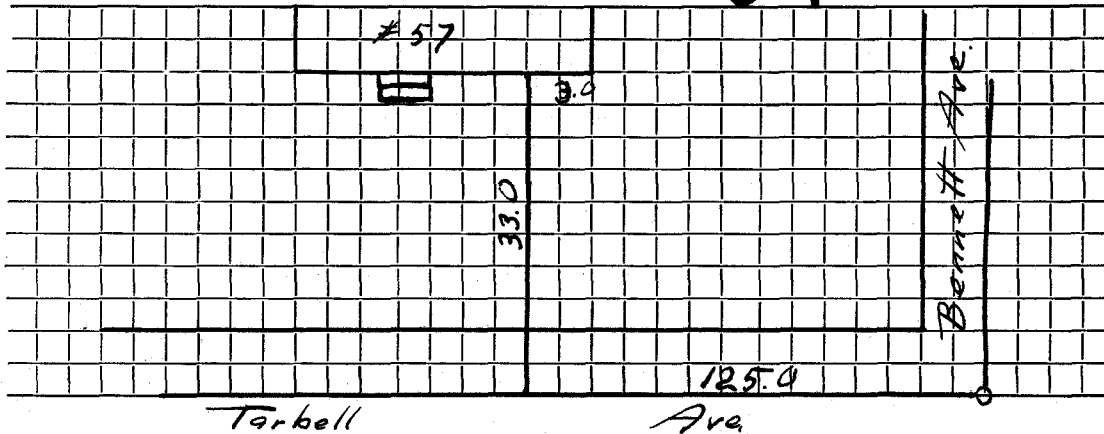

Connection made in Street. Work completed 19..

Remarks: