

Name Alice M. Reardon

Service No. 122

Address 60 Tarbell Avenue

60 Tarbell Ave.

Location

Kind of Pipe

Size 6"

Size of Main 8"

~~Repair - Renewal~~ - New Service

com. 8-15-55

Location

Date	Material	Amount	Total	Date		Amount
6/29/55	Labor	46 80		6-20-55	Deposited	100 00
	10% Overhead	4 68	51 48	8-15-55	Paid	(2 64)
	32'-6" Sewer Pipe @ .32		10 24			102 64
	Joint Compound		1 92			
	5 hrs. Littlefield Shovel @ .75		37 50			
	2 hrs. Trucking @ .75		1 50			
			102 64			
	Labor					

**TOWN OF LEXINGTON—DEPT. OF PUBLIC WORKS**  
**SEWER DIVISION**

DATE .....

NO. ....

The undersigned applies for the construction of a particular sewer connecting No. ....  
Street and hereby agrees to comply with the Rules and Regulations governing the construction and use of Particular  
Sewers, as now or at any future time established by the Board of Selectmen.


Am't of estimate \$. ....

Am't Paid \$. ....

..... Owner

---

**Sketch of Service Here**

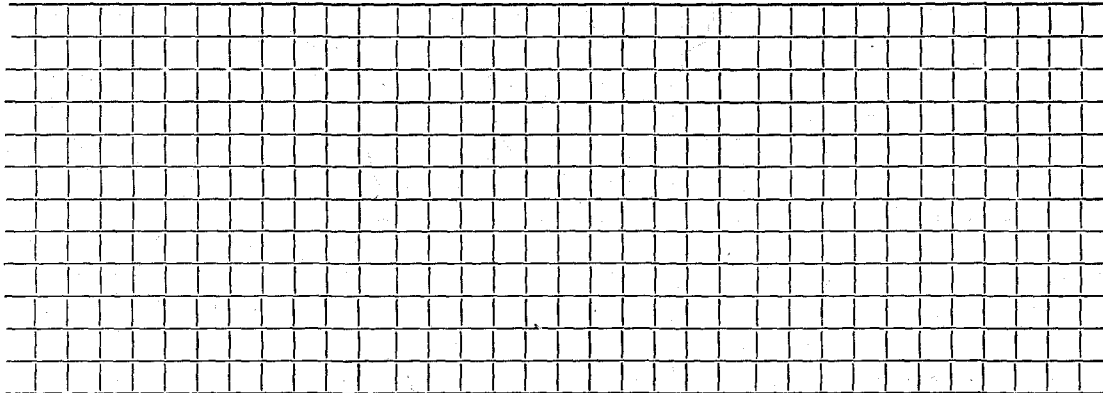

Connection made in ..... Street.

Work completed ..... 19..

Remarks: