

Name Dominic Falcone

Service No. 12

Address 62 Tarbell Avenue

62 Tarbell Ave.

Location

Kind of Pipe

Size 6"

Size of Main 8"

~~REPAIR PERMIT~~ - New Service W.O. #1768

De Floc Bros Permit # A185

Location JUN 27 1966


Date	Material	Amount	Total	Date	Amount
3-11-66	Labor 115.58			3-8-66	150 00
3-22-66	Labor 28.66			7-11-66	24 89
3-23-66	Labor 9.52	153 76		8-14-66	75 11
	10% O.H.	15 38	169 14		32 90
26'	6" Transite pipe @ .82		21 32		
1/2	Bag Cement @ 1.50		75		
1	Plug		1 33		
	12" X 8" Patch		12 X 8 X		
2 1/2	Ton Hot Top @ 5.50		13 75		
4	Hrs. Truck @ 3.00		12 00		
3	Hrs. Shovel @ 6.50		19.50		
1	Hr. Trailer		2 00		
1	Hr. Roller		3 00		
1	Hr. Compressor		5 00		
			152 X 79		
3/15/66	15' 6" Transite pipe		247 79		

247.79 = 9.91 x 7.5 = 75.11
25

DATE _____

TOWN OF LEXINGTON — BOARD OF PUBLIC WORKS
SEWER DIVISION

Sketch of Service Here **62**

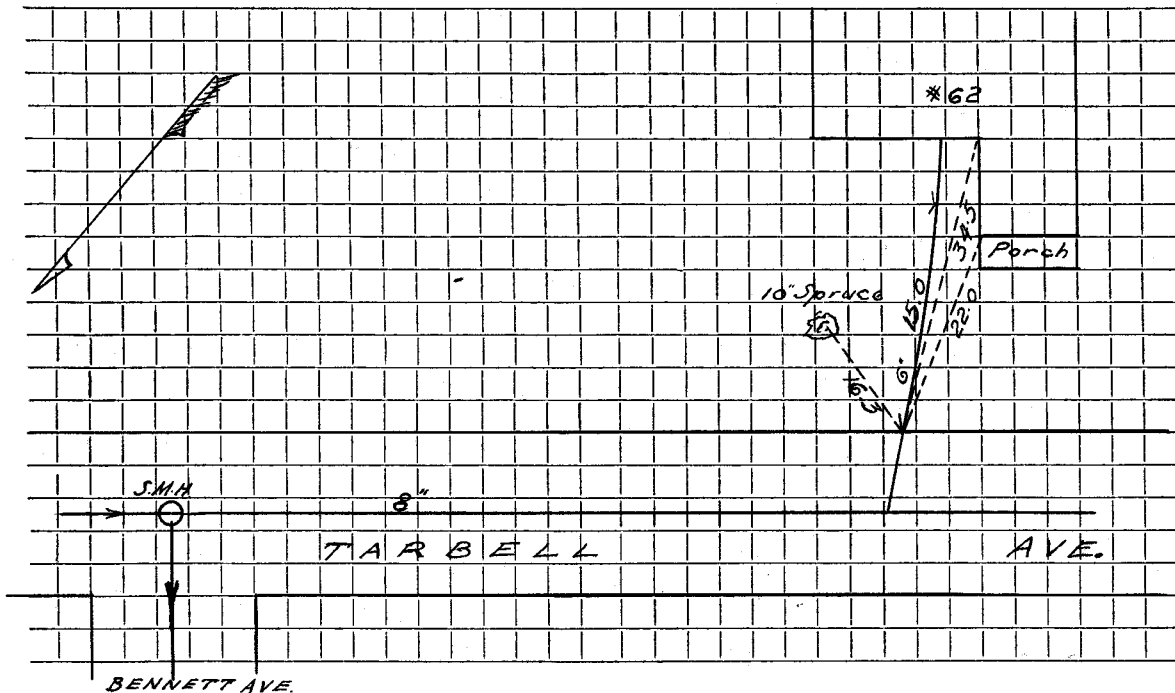

Connection made in Street. Work completed

Remarks: Original Service 10-6-58 (39'-6" Transite, 1-6"x8" clay Y)