




DATE \_\_\_\_\_

TOWN OF LEXINGTON — BOARD OF PUBLIC WORKS  
SEWER DIVISION

Sketch of Service Here **7**

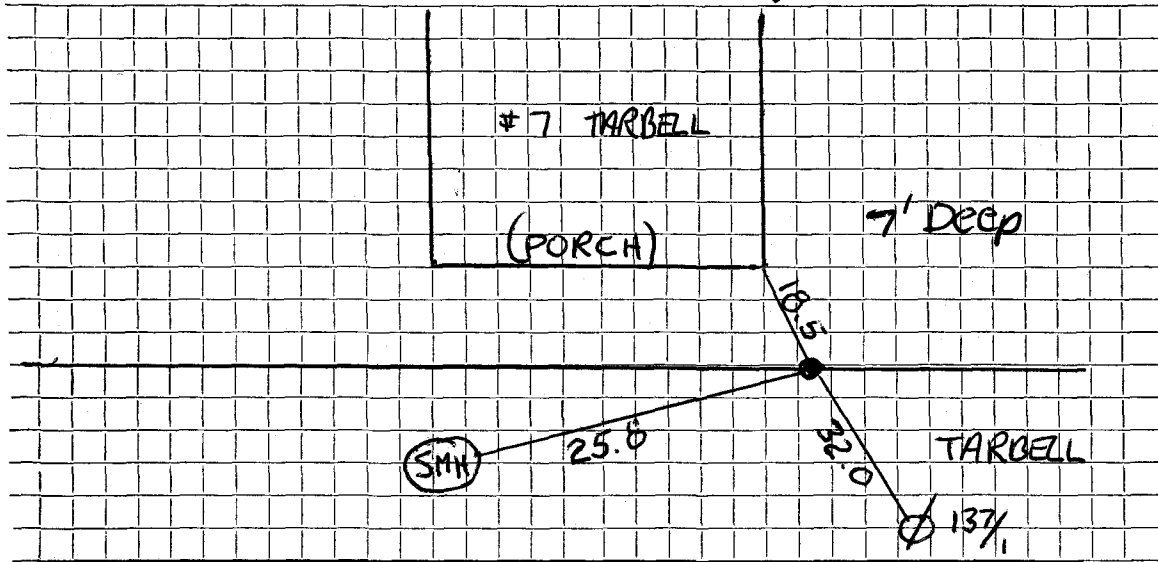

INVERT ELEVATION 255.50 BENCH MARK:  $\odot$  CORNER OF TAFT & TARBELL 255.96  
HYD. SPINDLE  $\odot$

Connection made in ..... Street. Work completed .....

Remarks: .....

.....  
.....