

Name

Service No.

Address #16 Tavern home Fed off Elliot St

Location

Kind of Pipe 6" PVC

Size 6"

Size of Main 8"

Repair—Renewal—New Service

Location

Date

Material

Amount

Total

Date

Amount

7/19


8' ft PVC

DATE 7/19

TOWN OF LEXINGTON — BOARD OF PUBLIC WORKS

SEWER DIVISION

Sketch of Service Here

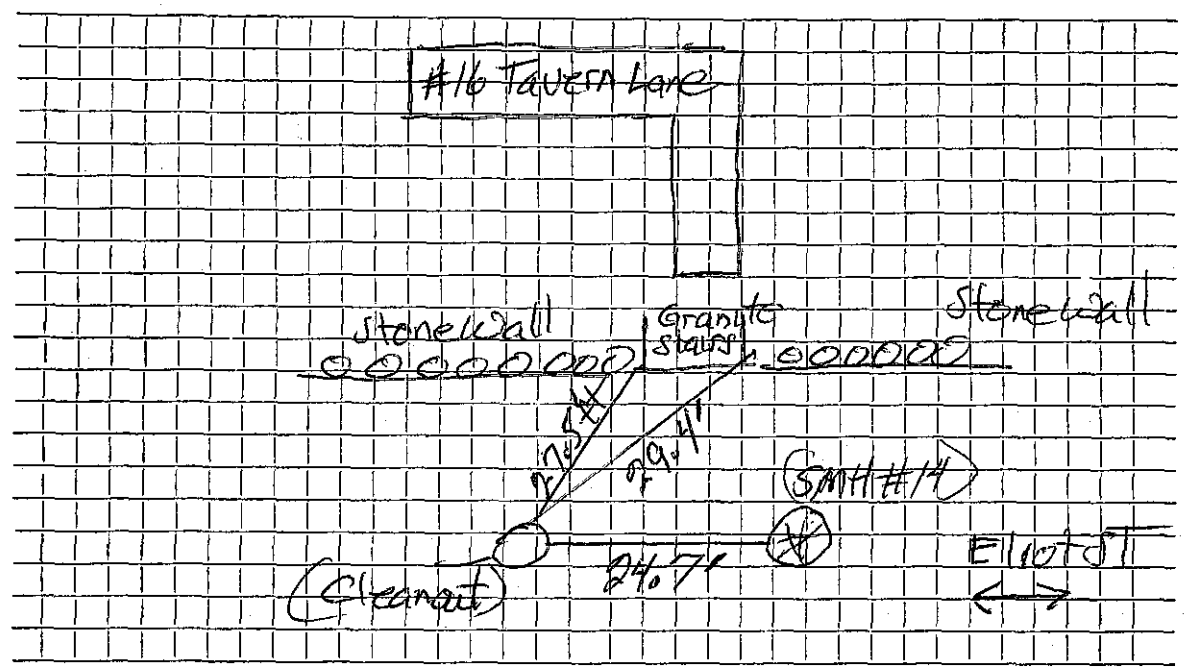

Connection made in Eliot St Street. Work completed

Remarks: #16 Tavern Lane. Fed off Eliot Street. Buried in Stone, Caution Tape on Top w/ Fabric: