

Name Mark Moore

Service No. 17

Address 10 Tavern Lane

Location

Kind of Pipe

Size

Size of Main

~~Repair or Renewal~~ — New Service W.O. #4236 DeFluce #554

Location JAN 22 1968


Date	Material	Amount	Total	Date	Amount
4/13/67	80' 6" Transite pipe			8-30-67	100 00
	10" 4" Cast Ironpipe			1-22-68	33 44
3-31-67	Labor 64.34	64 34			123 66
	10% O.H.	6 43	70 77		
	20' 6" Transitepipe @.88		17 60		
	1/2 Bag Cement @1.55		78		
	12 Bricks		51		
	1 Ton cold Patch 5.00		5 00		
	4 Hrs. Trucking @3.00		12 00		
	2 Hrs. Shovel @6.50		13 00		
	1 Hr. Loader @4.00		4 00		
			123 66		

DATE _____

TOWN OF LEXINGTON — BOARD OF PUBLIC WORKS

SEWER DIVISION

Sketch of Service Here **10**

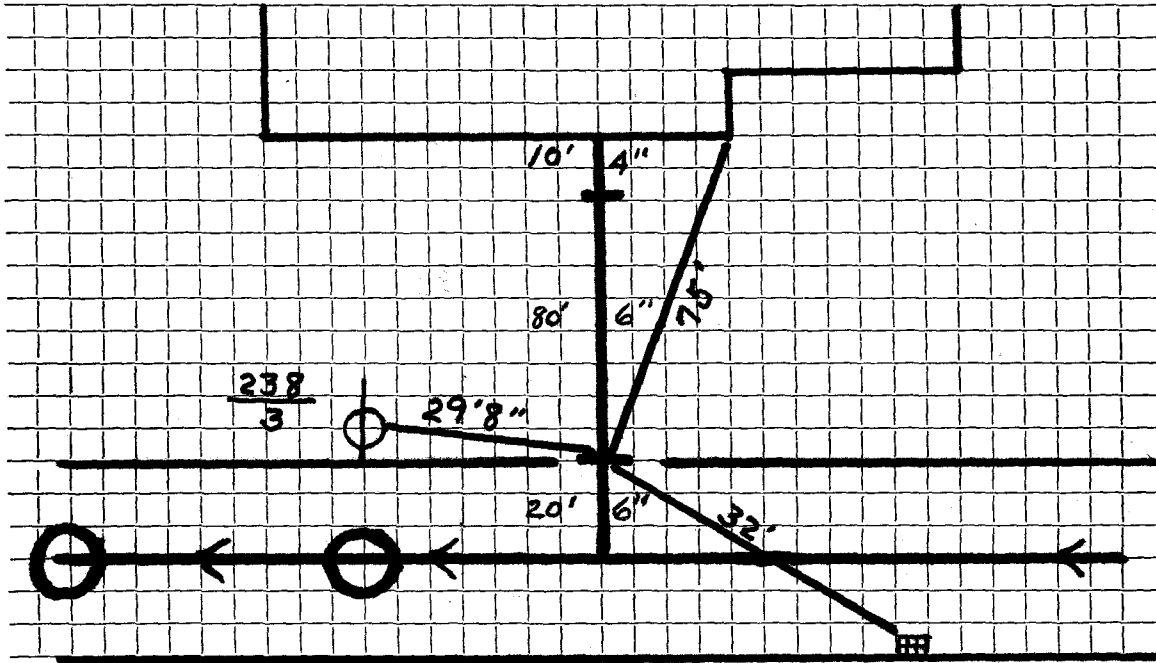

Connection made in Street. Work completed

Remarks:
.....
.....