


# TOWN OF LEXINGTON — BOARD OF PUBLIC WORKS SEWER DIVISION

Sketch of Service Here

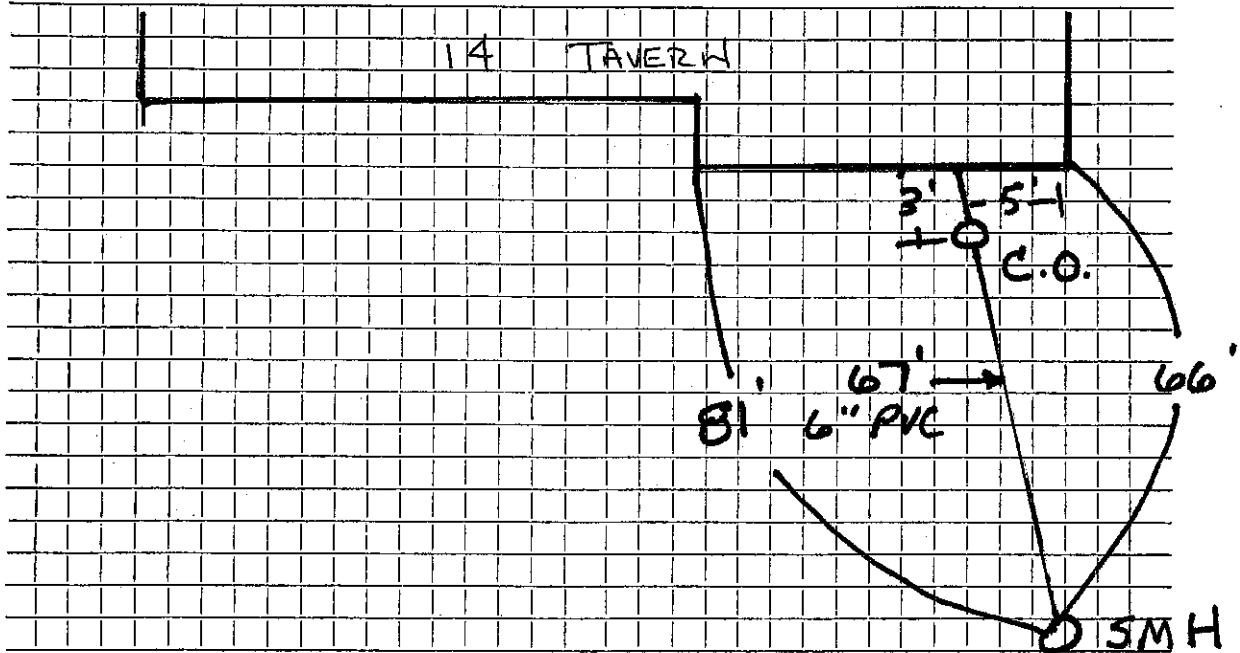

DEPT.

Connection made in ..... Street. Work completed .....

Remarks: .....

