


DATE _____

TOWN OF LEXINGTON — BOARD OF PUBLIC WORKS

SEWER DIVISION

Sketch of Service Here **7**

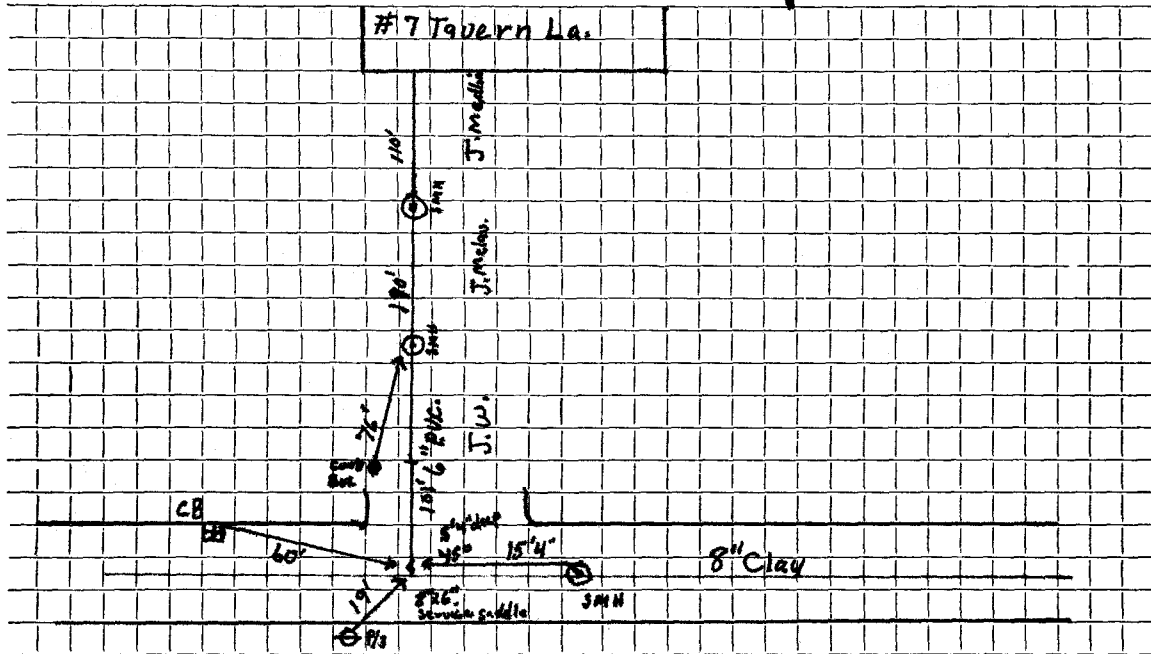

Connection made in *Tavern La.* Street. Work completed

Remarks: *Sewer is to right of water. Side by side. Goes under water main.*
.....
.....