


DATE 9 JUNE 1994

TOWN OF LEXINGTON — BOARD OF PUBLIC WORKS
SEWER DIVISION

Sketch of Service Here

9

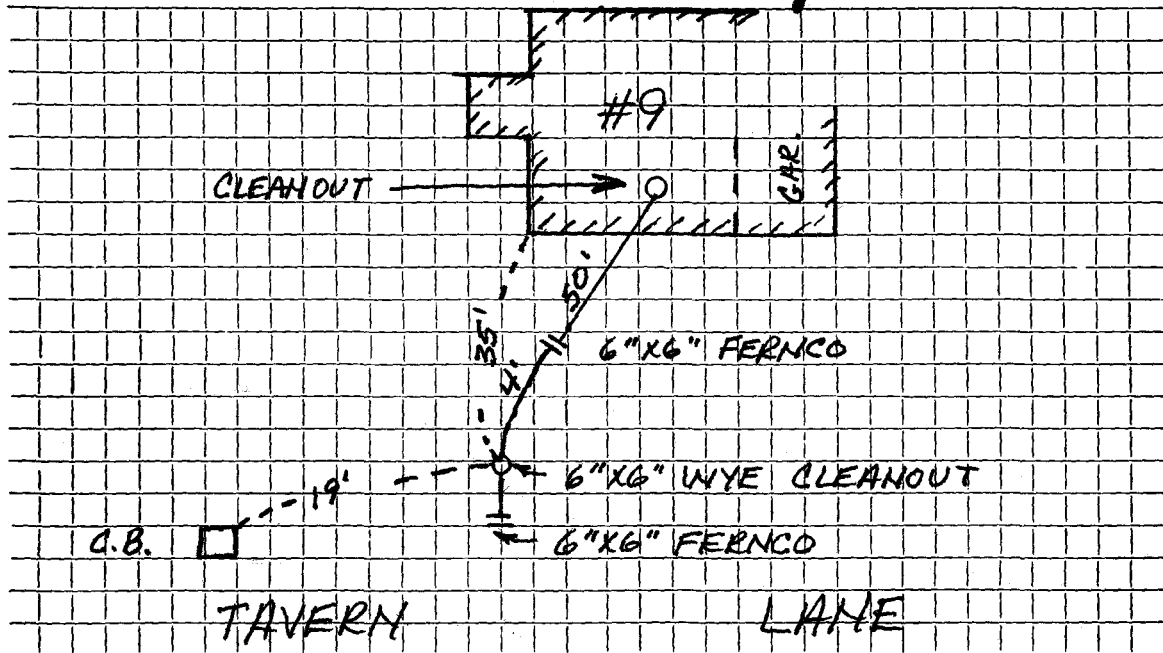

Connection made in TAVERN LANE Street. Work completed VALERIE
Remarks: Original Service 5-7-57 (80'-6" Transite)