

Name Albert H. Bettencourt

Service No. 65

Address 2 Tewksbury Street

2 Tewksbury Street

Location

Kind of Pipe

Size 6"

Size of Main 8"

~~REPAIR RENEWAL~~ - New Service

W O # 8688

Location

Com 7-21-64

Date	Material	Amount	Total	Date	Amount
6-5-64	Labor	113 15		4-27-64	150 00
	10% O.H.	11 32	124 47	10-6-64	28 00
	40' 6" Transite pipe @.82		32 80		178 60
	1 Bag Cement		1 50		
	1 90° Transite Elbow		4 09		
	1 Duplex Adapter		1 62		
	1 11¼° Transite Bend		4 09		
	1 12" Nipple		1 21		
	1 6" Nipple		91		
	5' 4" Cast Iron Soil pipe		7 50		
	2 Yards Loam @ 3.00		6 00		
	8 X 3 Patch		8 00		
	2 Hrs Town Shovel @ 6.50		13 00		
	2 Hrs Trucking @ 3.00		6 00		
			211 19		
	PRO-RATED	211.19 X 21 = \$178.00			

Bill sent 21.00


DATE _____

TOWN OF LEXINGTON — BOARD OF PUBLIC WORKS

SEWER DIVISION

Sketch of Service Here

2

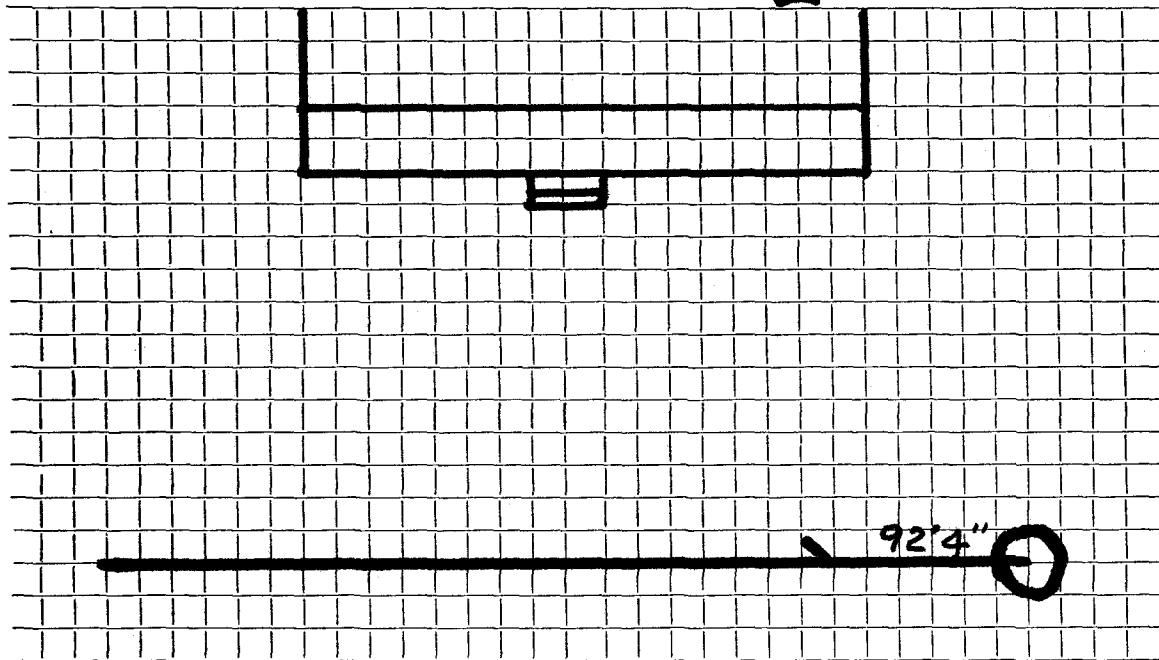

Connection made in Street. Work completed

Remarks: *Original Service 5-11-43 (30'-6" Sewer Pipe, 1-6" Elbow)*