

Name

Service No.

Address

4 Tewksbury Street

Location

Kind of Pipe

Size 6"

Size of Main 8"

Repair—Renewal—New Service

Location

Date

Material

Amount

Total

Date

Amount

4-21-44

60' 6" VC Pipe


10' 6" C.I. Pipe

1 6" - 1/4" Bend

DATE _____

TOWN OF LEXINGTON — BOARD OF PUBLIC WORKS
SEWER DIVISION

Sketch of Service Here **4**

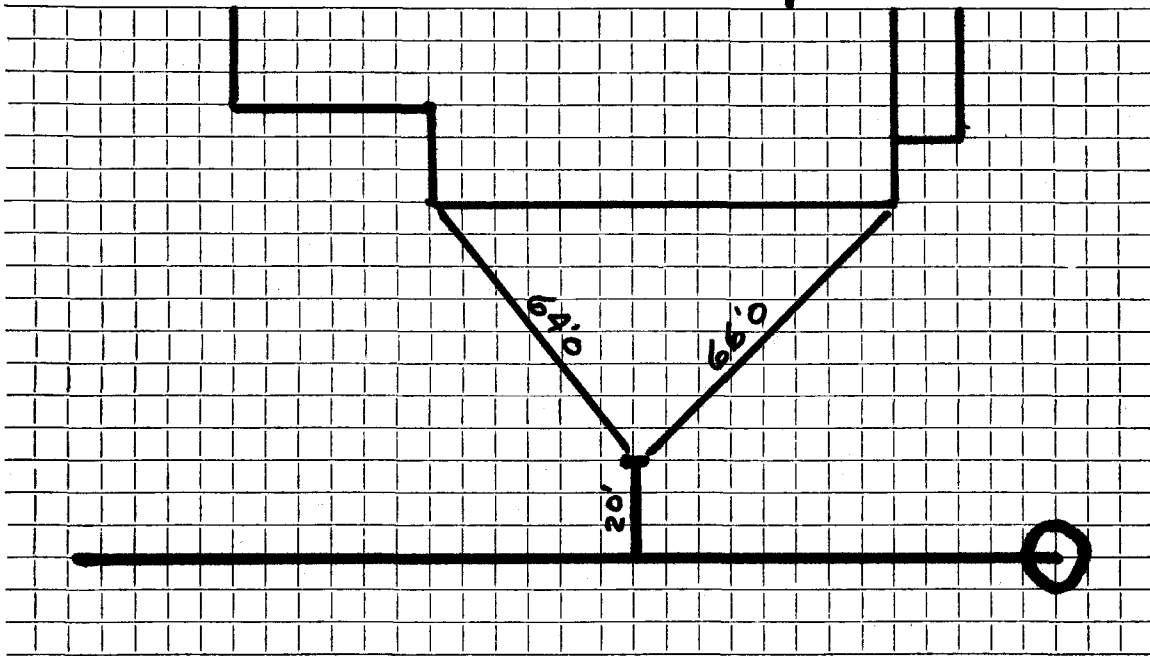

Connection made in Street. Work completed

Remarks:
.....