

Name

Service No.

Address 6 Tewksbury St.

6 Tewksbury Street

Kind of Pipe

Size 6''

Size of Main 8''

Location

Repair—Renewal—New Service


Location

Date	Material	Amount	Total	Date	Amount
7-28-33					
36'	6" Sewer Pipe				
1	6" x 8" Wye				

DATE \_\_\_\_\_

TOWN OF LEXINGTON — BOARD OF PUBLIC WORKS  
SEWER DIVISION

Sketch of Service Here **6**

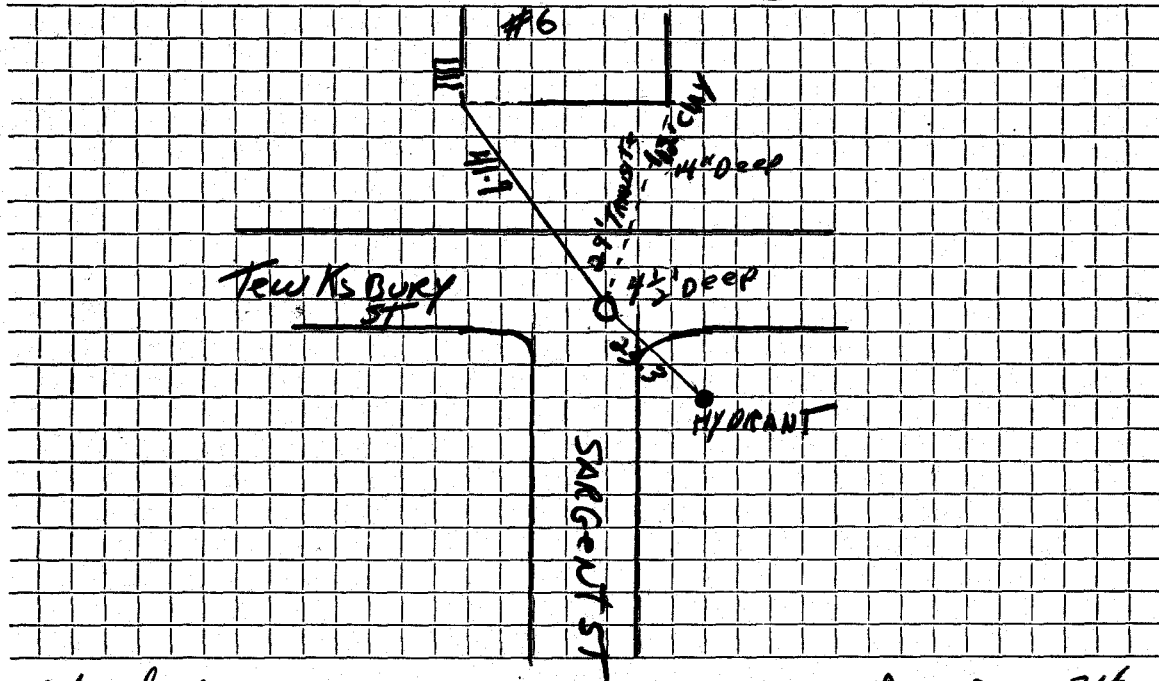

Connection made in 6. tewksbury Street. Work completed DEC 20-74

Remarks: Installed 29' 6" TRANSITE from manhole to just beyond property line.