

Section No. 984

Ordering Agency

Address 15 Theresa Ave.

15 Theresa Ave. Location Same

Kind of Pipe Size of Main 8"

Size 6"

Location

MANIPULATOR - New Service

Date	Material	Amount	Total	Date	Amount
1935 June 19 1767 Com. & Russell Albany	8 hrs. @ .60¢	4 80		May 20 Deposited	18 00
	8 " @ .55¢	4 40		July 16 Reimbursed	32
	10% Over. on labor	92	10 12		17 67
	20' 6" Sewer Pipe @ 20¢		4 00		
	1 1/8" Band		1 80		
	Sulphur & Jute		75		
	Trucking		1 00		
			17 67		
	Labor				

TOWN OF LEXINGTON—BOARD OF PUBLIC WORKS
SEWER DIVISION

DATE May 21, 1935

NO. _____


The undersigned applies for the construction of a particular sewer connecting No. 15 Theresa Ave. Street and hereby agrees to comply with the Rules and Regulations governing the construction and use of Particular Sewers, as now or at any future time established by the Board of Selectmen.

Am't. of Estimate \$ 18.00

Am't. Paid \$ _____

Catherine H. Donnan Owner

Sketch of Service Here

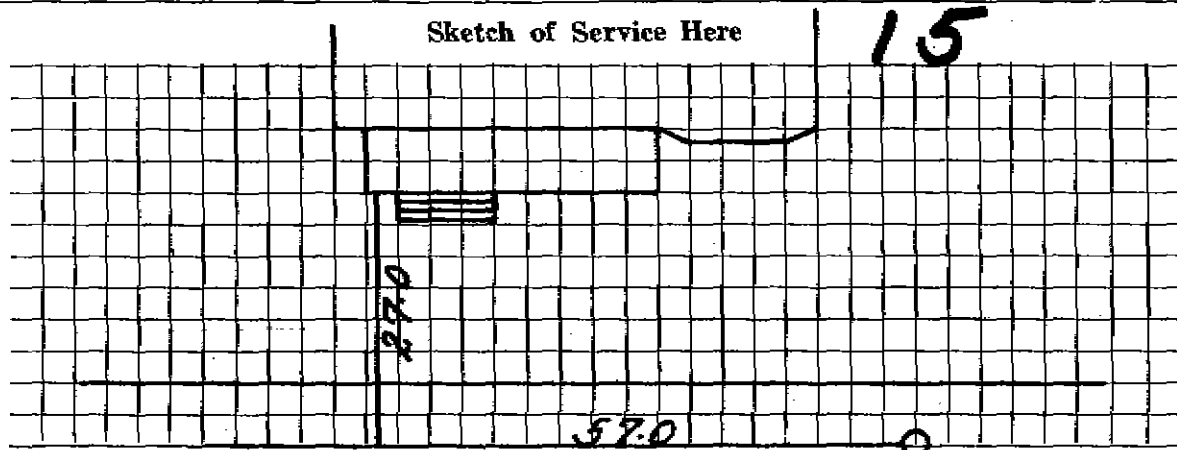

Connection made in _____ Street.

Work completed _____ 19

Remarks: