

Name

Arlington Gasop. Bank

Service No.

17

Address

Arlington, Mass.

24 Theresa Ave

Theresa Ave.

Kind of Pipe

Size 6"

Size of Main 8"

Repairs-Old Sewer - New Service

Location

Date		Material	Amount	Total	Date	Amount
6/15/32	26	6" Sewer Pipe @ .15	3 90	\$6 99	July 9 1932 - Cash	35 88
6-21-32	2	6"-1/8 Bends @ .65	1 30			
		Sulphur & Jute	1 04			
		Trucking	75			
6/15/32	34	2/3 Hr. Labor @ .50	17 33	27 73		
	17	1/3 " " @ .60	10 40			
		15% Overhead	4 16			
			38 88			
		Labor				

Hilled Press, Inc., Lexington

TOWN OF LEXINGTON—BOARD OF PUBLIC WORKS
SEWER DIVISION

DATE _____

NO. _____


The undersigned applies for the construction of a particular sewer connecting No. _____
Street and hereby agrees to comply with the Rules and Regulations governing the construction and use of Particular
Sewers, as now or at any future time established by the Board of Selectmen.

Am't. of Estimate \$ _____

Am't. Paid \$ _____

Owner

Sketch of Service Here

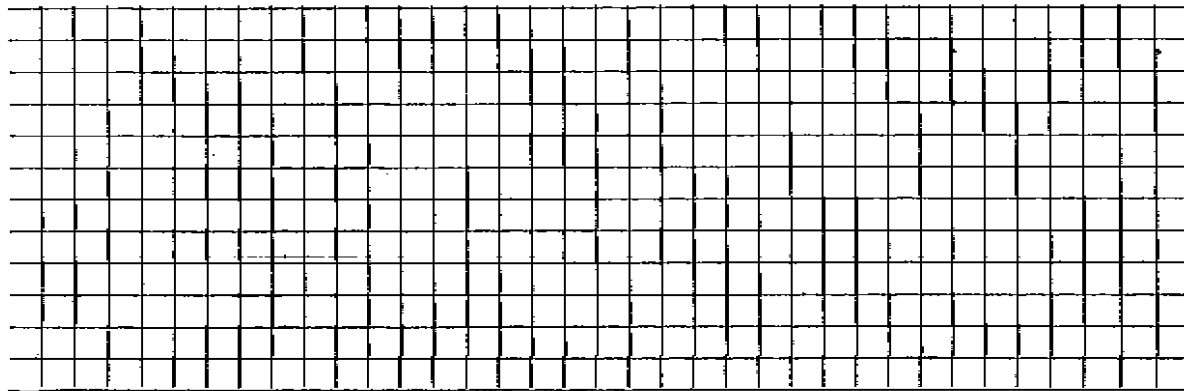

Connection made in _____ Street.

Work completed _____ 19

Remarks: