

George V. Porter

Service No. 754

Address 25 Theresa Avenue, Lexington

25 Theresa Ave Location

Kind of Pipe

Size 6"

Size of Main 8"

Repaired - New Service

Location

Date				Material		Amount		Total		Date		Amount	
June 27 '39				12 1/2 hrs. @ 50¢		6 25				June 21, 1939		Deposited 50 00	
Com 7-17-39				5 " 55¢		2 75				July 24, 1939		Refunded 18 37	
				14 1/2 " 60¢		8 70						31 63	
				4 " 65¢		2 60		20 30					
				10% Overhead				2 03					
				30' 6" Sewer Pipe @ 20¢				6 00					
				Jointing compound				1 80					
				2 hrs. Trucking @ 75¢				1 50					
								31 63					
11/2/2000				10' 6" PVC									
				2-6" Clay x PVC FENCE									
				(NO ROOTS IN ST.)									
				Labor									

Hudley Bros, Inc., Lexington

TOWN OF LEXINGTON—BOARD OF PUBLIC WORKS
SEWER DIVISION

DATE _____


NO. _____

The undersigned applies for the construction of a particular sewer connecting No. 25 Thurner Ave Street and hereby agrees to comply with the Rules and Regulations governing the construction and use of Particular Sewers, as now or at any future time established by the Board of Selectmen.

Am't. of Estimate \$ ~~5000~~ owner dig

Am't. Paid \$ _____

George W. Porter Owner

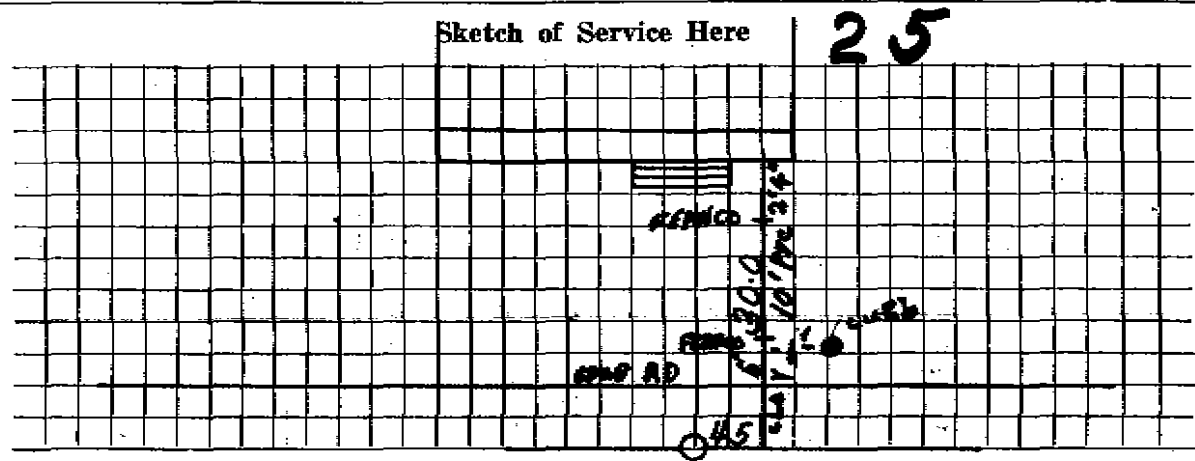

Connection made in _____ Street. Work completed _____ 19__

Remarks: REPLACED 10' OF CLAY W/ PVC. Broken when INST. WATER
FERNCO 5' FROM EDGE OF RD. WATER SAME TRENCH