

Address 28 Theresa Avenue, Lexington, Mass.

28 Theresa Ave. Location

Kind of Pipe

Size 6"

Size of Main 8"

Repair—Renewal—New Service

Location

| Date 1941   | Material                | Amount | Total   | Date                      | Amount               |
|-------------|-------------------------|--------|---------|---------------------------|----------------------|
| Sept. 3     | 54 hrs. @ 50¢           | 27 00  |         | August 18, 1941 Deposited | 50 00                |
| Com 11/3/41 | 14 " @ 60¢              | 8 40   |         |                           |                      |
|             | 11 " @ 75¢              | 8 25   | ✓ 43 65 | Dec 29, 44 Abated         | 9 72                 |
|             | 10% Overhead            |        | ✓ 4 36  |                           |                      |
|             | 38' 6" Sewer Pipe @ 16¢ |        | ✓ 6 08  | Bel # 91                  |                      |
|             | Jointing compound       |        | ✓ 2 88  |                           |                      |
|             | 1 6" 1/8 Bend           |        | ✓ 60    |                           |                      |
|             | Tractor, 1 hr.          |        | ✓ 1 25  |                           |                      |
|             | Trucking, 2 hrs. @ 75¢  |        | ✓ 1 50  | Oct 27, 1941 Bill sent.   |                      |
|             |                         |        | 59 72   | 4/27/42 " "               |                      |
|             |                         |        |         | 10/6/42 " "               |                      |
|             | Labor                   |        |         | 9/27/49                   | ply in main one more |

Hadley Press, Inc., Lexington

22/4/42 date 11/3/41

TOWN OF LEXINGTON—BOARD OF PUBLIC WORKS

SEWER DIVISION

DATE

Aug 5 1941

NO


The undersigned applies for the construction of a particular sewer connecting No. 28 Theresa Ave Street and hereby agrees to comply with the Rules and Regulations governing the construction and use of Particular Sewers, as now or at any future time established by the Board of Selectmen.

Am't. of Estimate \$ 50<sup>00</sup>

Am't. Paid \$ \_\_\_\_\_

Louis Ruocco.  
28 Theresa Ave Owner  
Ref. 08847m.

Sketch of Service Here

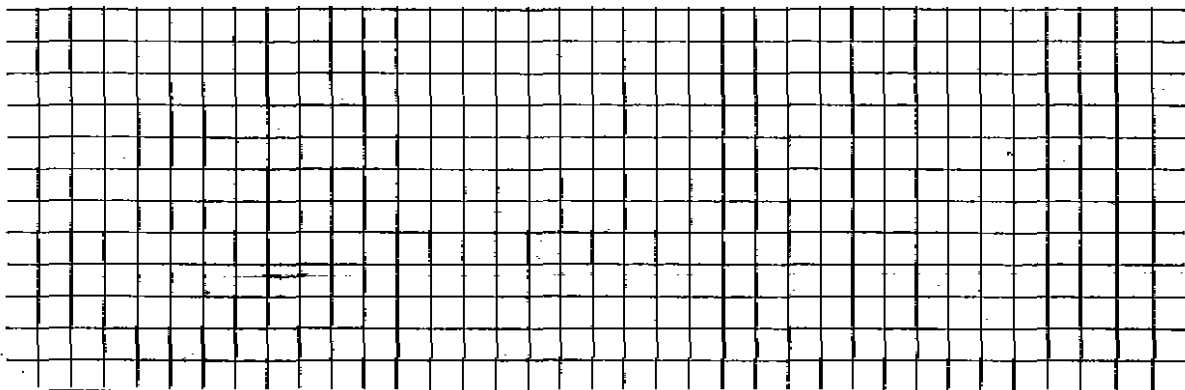

Connection made in \_\_\_\_\_ Street. Work completed \_\_\_\_\_ 19

Remarks: