

Name Albert Bertini

Service No. 19 1023

Address 30 Theresa Avenue

Lexington, Mass.

Location 30 Theresa Avenue

Kind of Pipe

Size 6"

Size of Main 8"

Repair General - New Service

Com 12-9-46

Location

Date	Material	Amount	Total	Date	Amount
June 22, '46	Labor	57 29	57 29	<i>May 28 '46</i>	<i>Reported</i> 90 00
	10% Overhead		5 73	<i>Dec 19 '46</i>	<i>Refunded</i> 9 10
	36' - 6" Sewer Pipe @ .256		9 22		80 90
	10' - 4" Soil Pipe @ .50		5 00		
	Joint Compound		2 16		
	Trucking 2 hrs. @ .75		1 50		
			80 90		
	Labor				

TOWN OF LEXINGTON—DEPT. OF PUBLIC WORKS
SEWER DIVISION

DATE


NO.

The undersigned applies for the construction of a particular sewer connecting No.
Street and hereby agrees to comply with the Rules and Regulations governing the construction and use of Particular
Sewers, as now or at any future time established by the Board of Selectmen.

Am't of estimate \$.....

Am't Paid \$.....

..... Owner

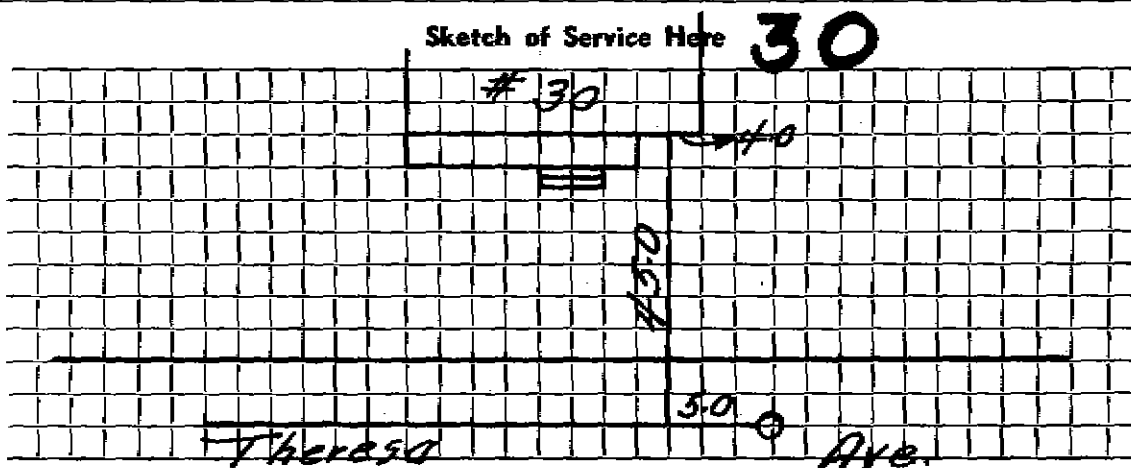

Connection made in Street.

Work completed 19..

Remarks: