

Name **Richard Sorrentino**

Service No. **1072**

Address **7 Theresa Ave., Lexington, Mass.**

7 Theresa Ave.

Location

Kind of Pipe

Size **6"**

Size of Main **8"**

~~Replaces Old Sewer~~ **New Service**

Location

Date 1943	Material	Amount	Total	Date	Amount
July 12	7 hrs. @ 60¢	4 20		<i>June 16, 1943 Deposited</i>	51 00
<i>Com 7/20/43</i>	28 " @ 65¢	18 20			
	11 " @ 70¢	7 70			
	10 " @ 80¢	8 00	38 10		
	10% Overhead		3 81		
	24' 6" Sewer Pipe @ 16¢		3 84		
	2 6" 1/8 Bends @ 67¢		1 34		
	Joint compound		1 44		
	1 hr. trucking		75		
			49 28		
	Charge: \$50.00				
	Labor				

Hedley Press, Inc., Lexington

TOWN OF LEXINGTON—BOARD OF PUBLIC WORKS

SEWER DIVISION

DATE June 14 1943

NO _____


The undersigned applies for the construction of a particular sewer connecting No. 7 Theresa Ave Street and hereby agrees to comply with the Rules and Regulations governing the construction and use of Particular Sewers, as now or at any future time established by the Board of Selectmen.

Am't. of Estimate \$ 50⁰⁰

Am't. Paid \$ _____

Richard Sventino Owner

Sketch of Service Here 7

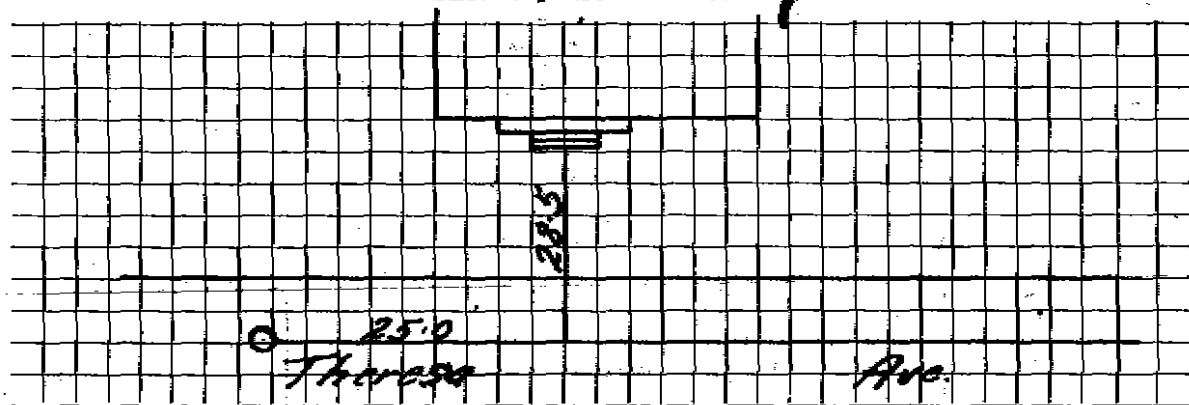

Connection made in _____ Street. Work completed _____ 19

Remarks: