

Address 46 THESDA WAY ARLINGTON

SEE FRONT OF PATROL LOG

Location

Kind of Pipe

Size

Size of Main

Repair—Renewal—New Service

Location


Date	Material	Amount	Total	Date	Amount
------	----------	--------	-------	------	--------

5/7/80	20 LF 6" AC @	15.00 = 1	300.00		
--------	---------------	-----------	--------	--	--

DATE 8/1/80

TOWN OF LEXINGTON — BOARD OF PUBLIC WORKS
SEWER DIVISION

Sketch of Service Here

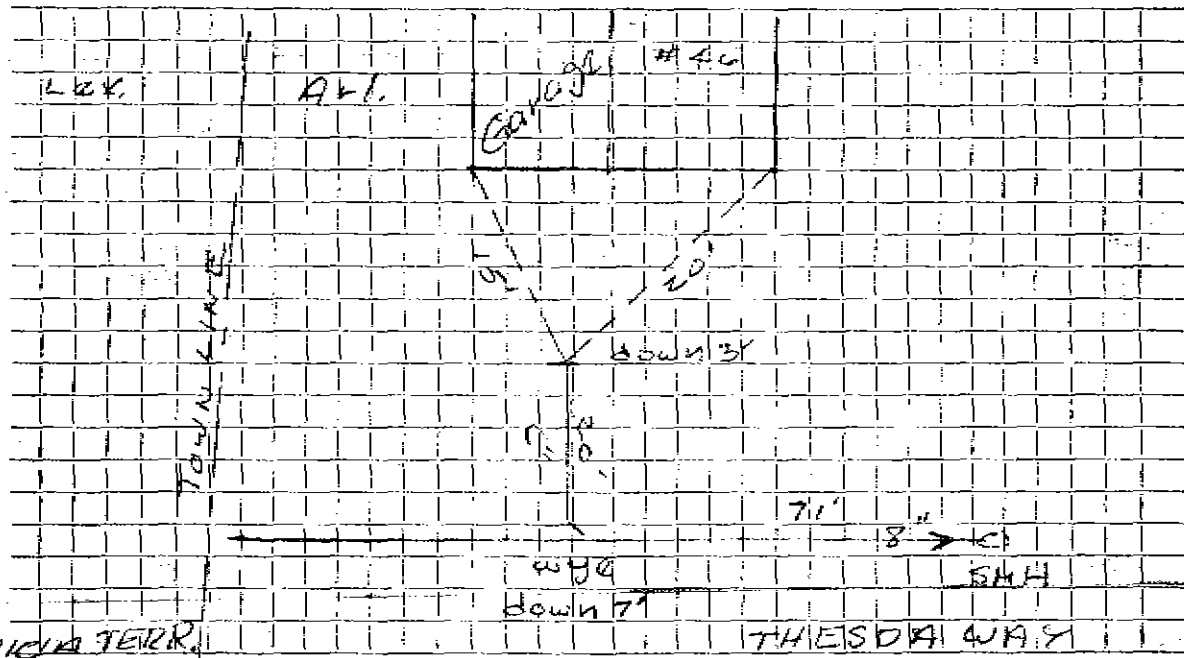

Connection made in THESDA WAY Street. Work completed

Remarks: