

Name Robert Buckley

Service No. 28

Address 3 Third St.

3 Third Street

Location

Kind of Pipe ACP

Size 6"

Size of Main 8"

~~Repair~~ ~~Renewal~~ New Service Valeri #4414

Location


Date		Material	Amount	Total	Date	Amount
8-2	73	16' @ \$9.00	144.00		6-26-87	144.00
7/2/87	57'	6" P.V.C.			Deposit	
	+ 11'	6" P.V.C.				
	1	6" Wye Co				
	1	AC to PVC Adpt.				
	1	6" Wye C.O.				
	1	6" x 4" Fernco				
	1	33° Sweep				
	1	22° Sweep				

TOWN OF LEXINGTON — BOARD OF PUBLIC WORKS

SEWER DIVISION

Sketch of Service Here

3

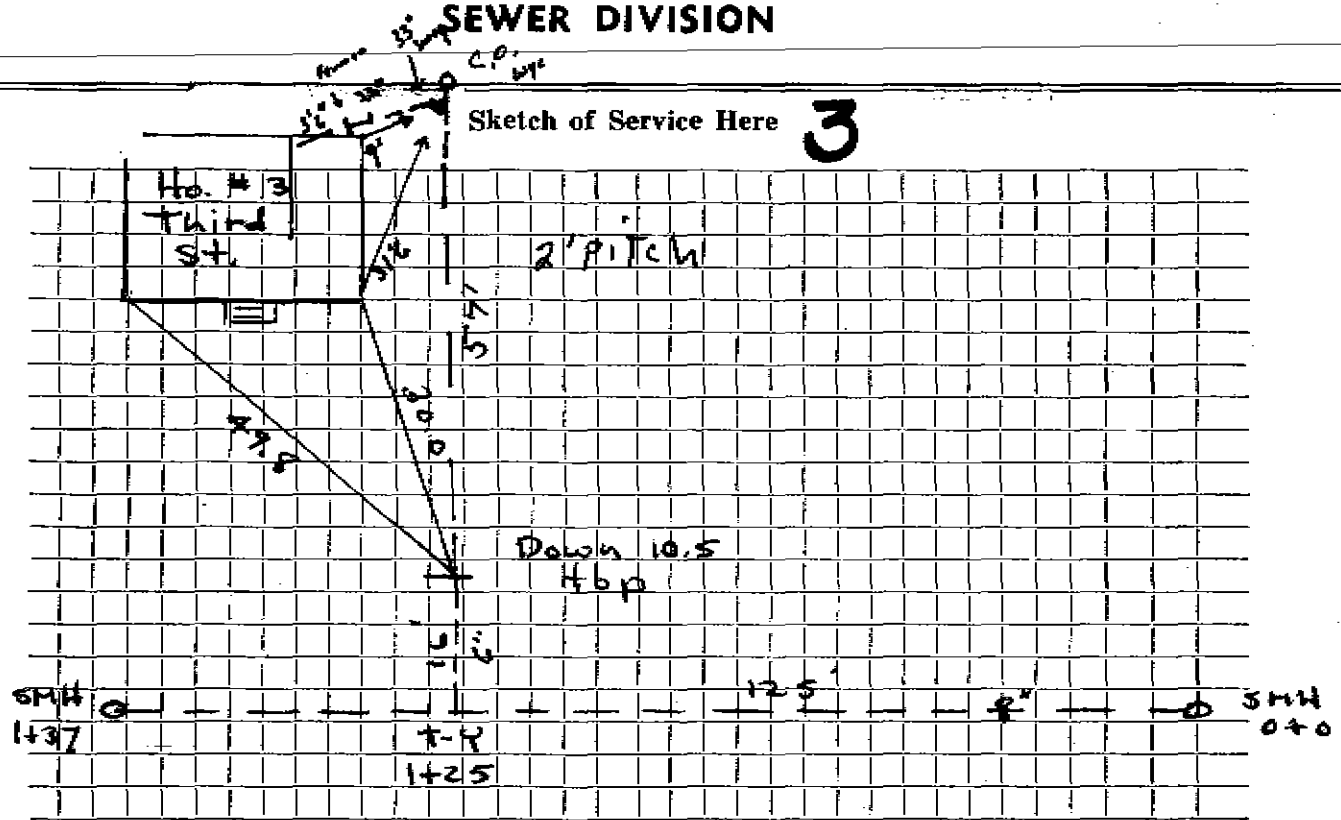

Connection made in W. 16 St. Street. Work completed

Remarks:
.....
.....