




DATE \_\_\_\_\_

# TOWN OF LEXINGTON — BOARD OF PUBLIC WORKS

## SEWER DIVISION

Sketch of Service Here **4**

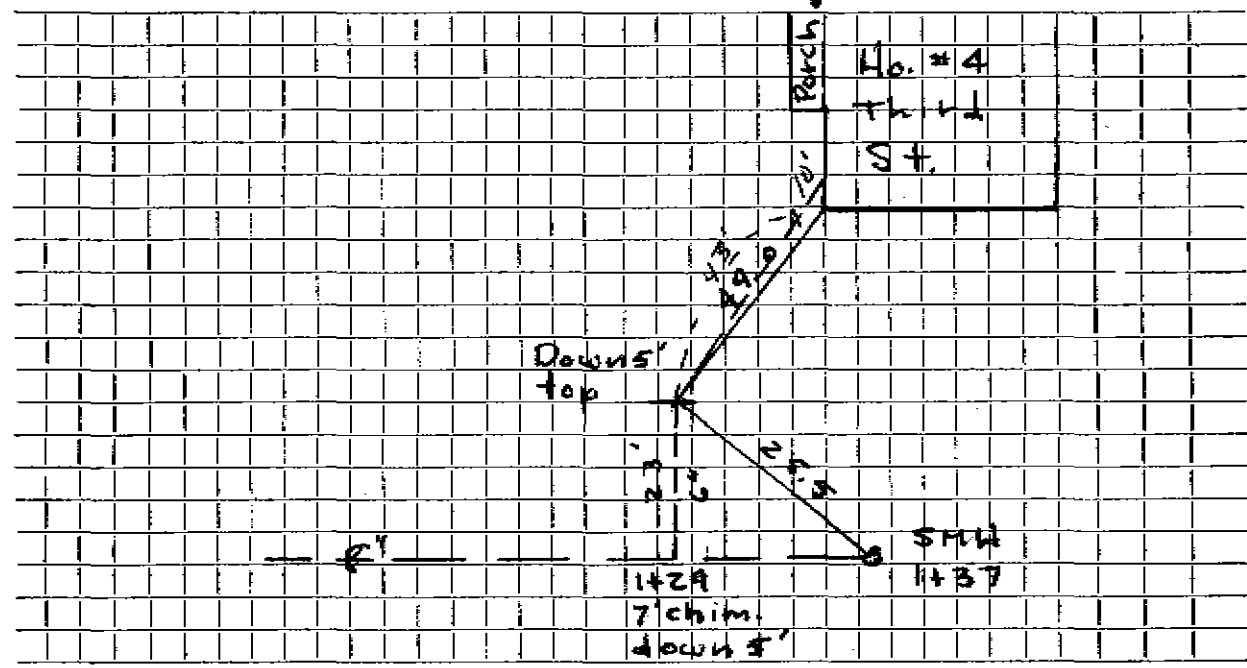

NOTE.  
 10' CI-4"  
 43' 6" A.C.

Connection made in Third St. Street. Work completed .....

Remarks: .....

.....

.....