

Name Brendan Walsh

Service No.

144 (75)

Address 6 Third Street

6 Third Street

Location

Kind of Pipe

Size 6"

Size of Main 8"

~~Sanitary Sewer~~ New Service W.O. # 4506

Devine #2824

Location MAR 15 1978


Date	Material	Amount	Total	Date	Amount
12/1/75	Labor	237.29		11-21-75	Deposit
12/2/75	"	157.94		3-15-76	Refund
12/4/75	"	49.30			1194 77
12/10/75	"	36.89	481.42		805 23
1	10% O.H.	48.14	529.56		
50'	6" Transite pipe @1.48		74.00		
1	6" x 6" Tee		8.32		
1	90° Elbow		5.48		
2	5' x 6" Nipple		15.60		
1	1' x 6" Nipple		2.44		
1	6" Cap		3.75		
1	bag cement		3.00		
12	yds. gravel @2.19		26.28		
4	ton Binder @3.70		54.80		
10	hrs. Trucking @3.00		30.00		
4	hrs. Lawn Shovel @6.50		26.00		
3	hrs. Compressor @5.00		15.00		
2	hrs. Loader @4.00		8.00		
1½	hrs. Roller @2.00		3.00		
6/2/76	54' 6" Transite Pipe		805.23		
E.S.S. 10501	10' 4" Cast Iron Pipe				

DATE _____

TOWN OF LEXINGTON — BOARD OF PUBLIC WORKS

SEWER DIVISION

Sketch of Service Here **6**

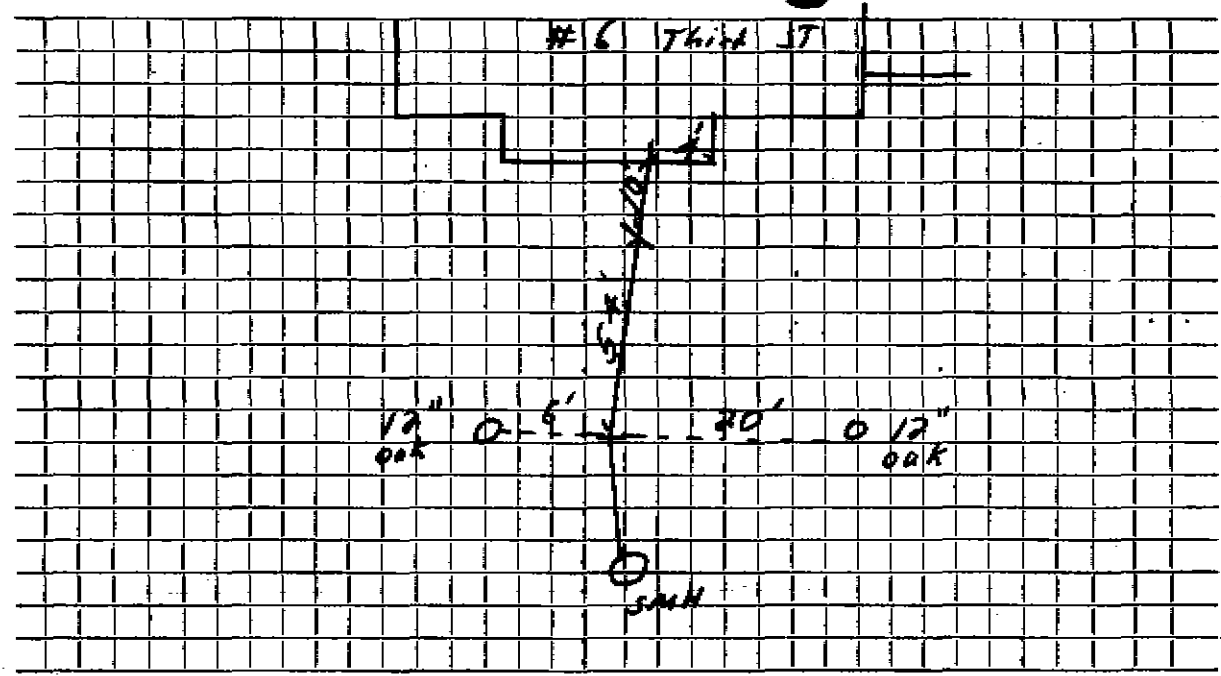

Connection made in Street. Work completed

Remarks:
.....
.....