

Name

Contractor: ST Frotton

Service No.

Address

27 Thorcau

Location

Kind of Pipe

SDR 21 PVC

Size

2"

Size of Main

Repair—Renewal—New Service

Location

Date

Material

Amount

Total

Date

Amount

10/30/18

6"x4" FernCo
to existing stub
4"x2" reducer

2" PVC SDR 21


140'

Depth = 4'6"

DATE 10/30/18

TOWN OF LEXINGTON — BOARD OF PUBLIC WORKS
SEWER DIVISION

Sketch of Service Here

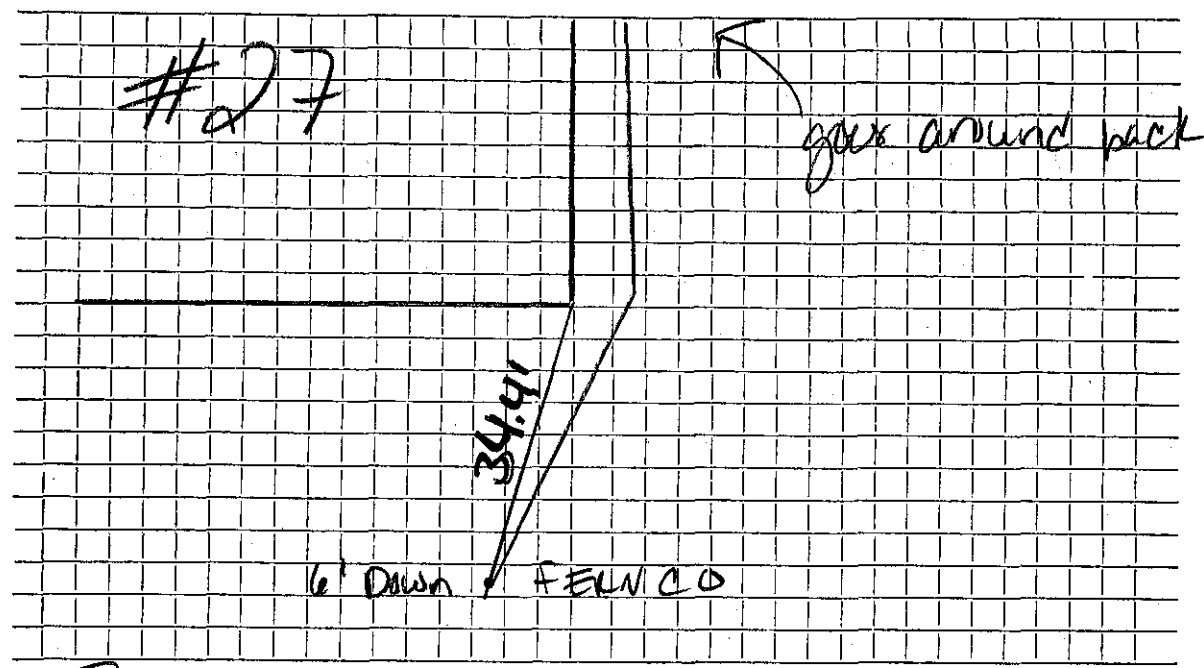

Connection made in Thorcau Street.

Work completed

Remarks: Septic Abandonment

Sewer pump approved by J. Livsey & D. Paulik