




DATE 4/16/2020

TOWN OF LEXINGTON — BOARD OF PUBLIC WORKS  
SEWER DIVISION

Sketch of Service Here

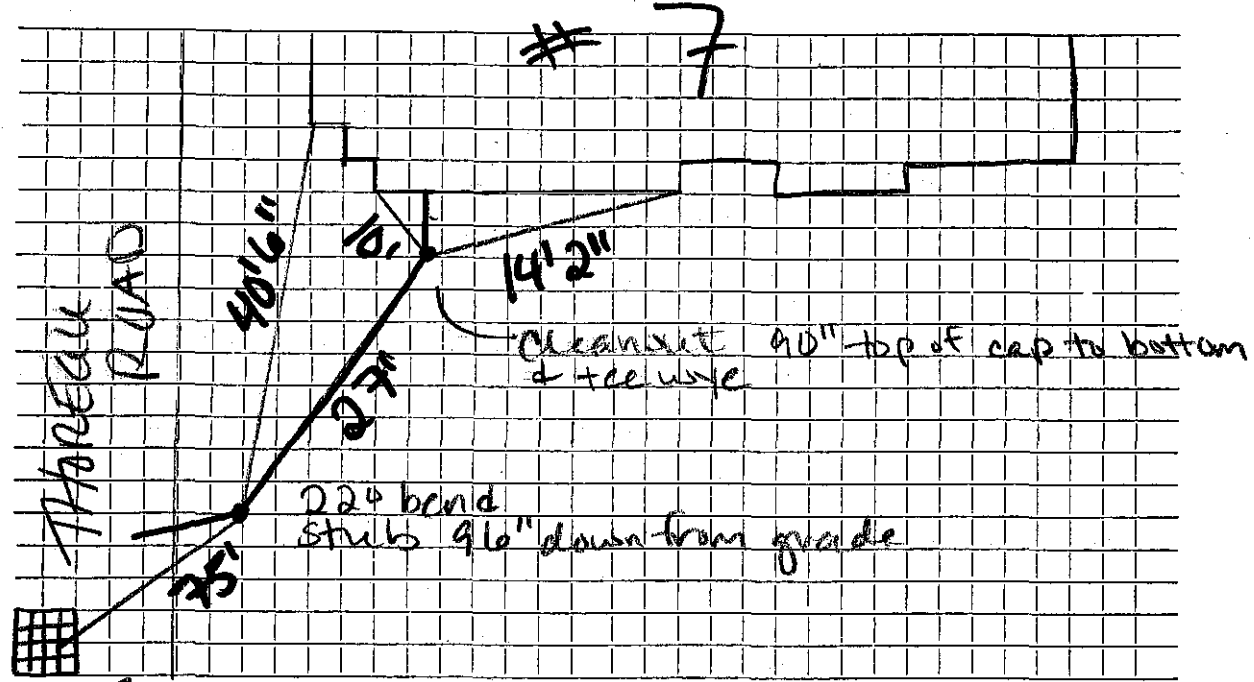

Connection made in Thorceau Rd Street. Work completed .....

Remarks: Inspection done through VPC due to COVID-19