


DATE 9-13-'90

TOWN OF LEXINGTON — BOARD OF PUBLIC WORKS
SEWER DIVISION

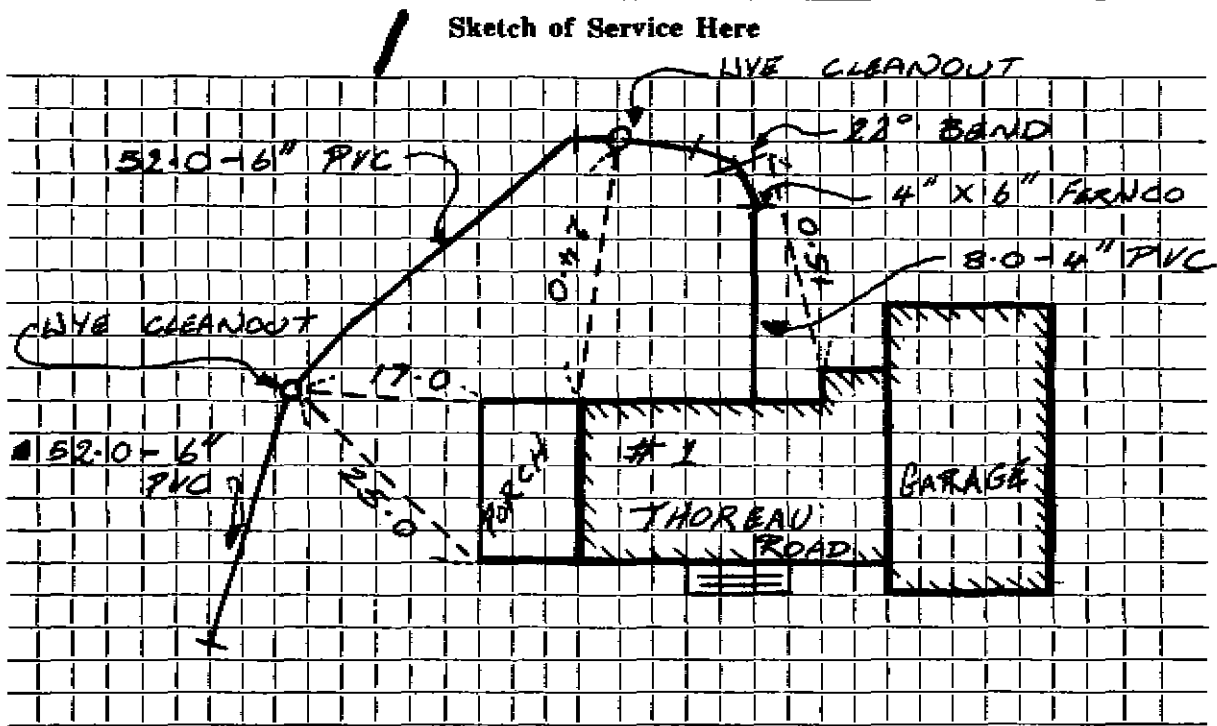

Connection made in THOREAU ROAD Street. Work completed

Remarks: