

Name Robert Cole

Service No. 80

Address 19 Thoreau Road

19 Thoreau Road

Location Lot #50

Kind of Pipe

Size 6"

Size of Main 8"

~~REPAIR WORK~~ New Service John Pevine #3184


Location FEB 13 1970

Date	Material	Amount	Total	Date	Amount
9/25/69 29'	6" Transite Pipe @	9.00	\$ 261 00	9-15-79	Deposit 261 00

SEWER DIVISION

Sketch of Service Here

19

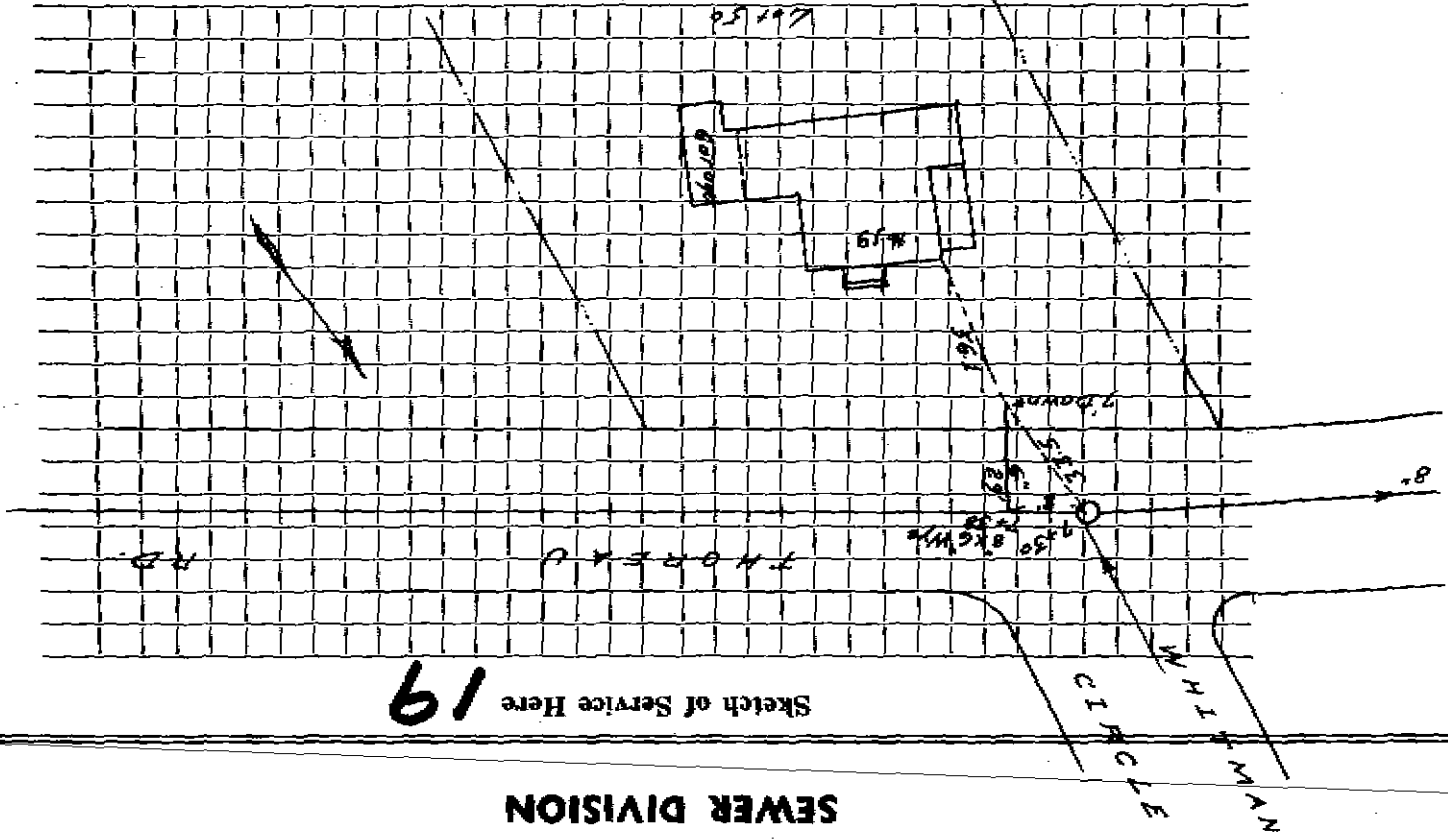

Connection made in _____

Street _____

Work completed _____

Remarks: _____