




Date: May, 2023

TOWN OF LEXINGTON - BOARD OF PUBLIC WORKS  
SEWER DIVISION

SKETCH OF SERVICE HERE  
23 Thoreau Rd

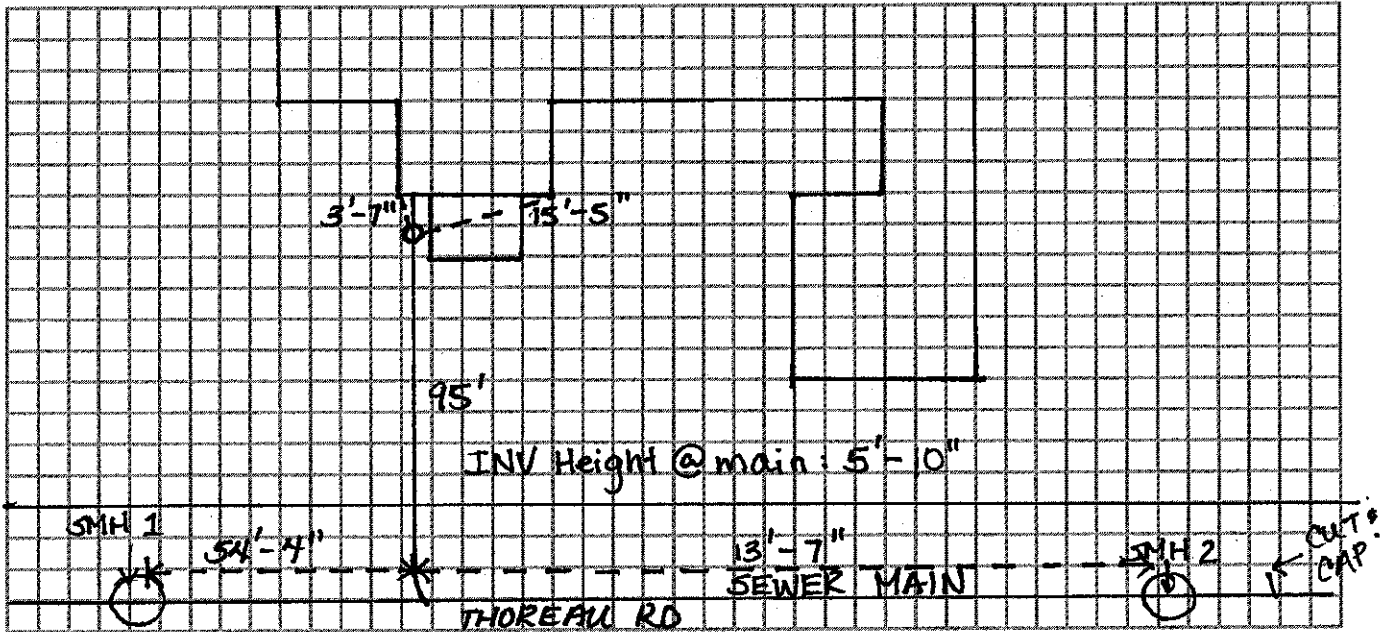

Connection made in:

Street.

Work completed:

Remarks: Installed by Santucci Construction