


TOWN OF LEXINGTON — BOARD OF PUBLIC WORKS

DATE 4/12/2021

SEWER DIVISION

Sketch of Service Here

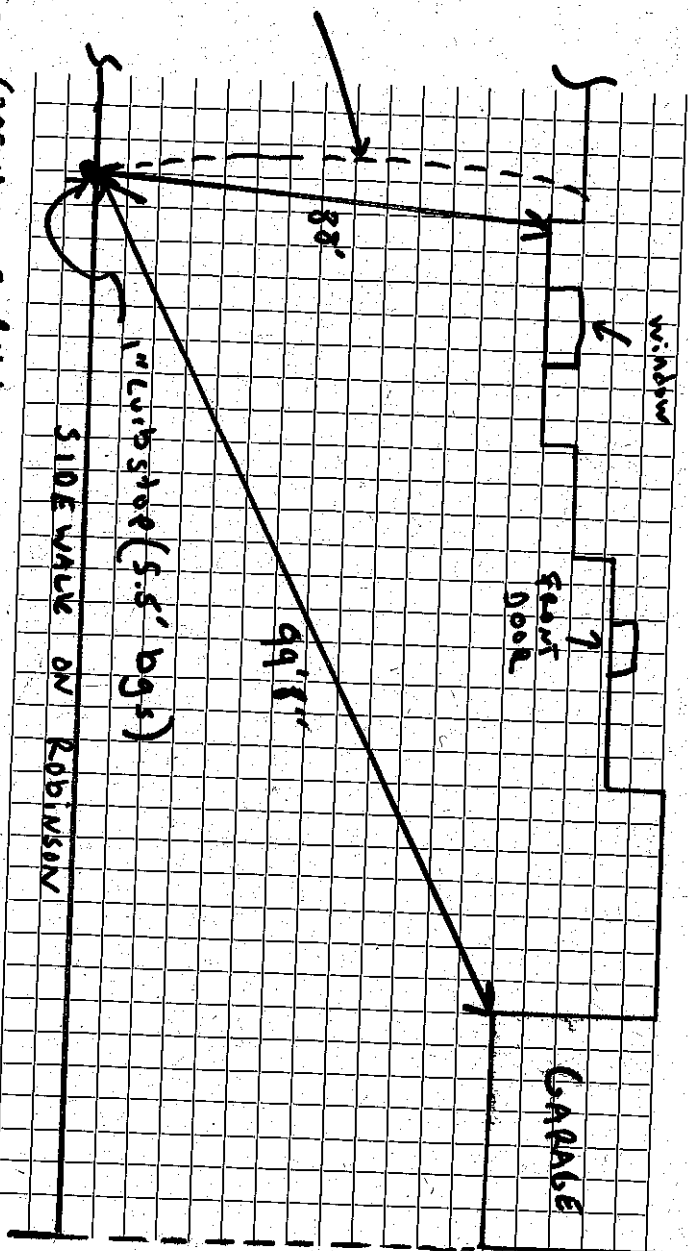

Connection made in SIDEWALK OF ROBINSON Street. Work completed 1' Leeward

Remarks:

DATE _____

TOWN OF LEXINGTON — BOARD OF PUBLIC WORKS

SEWER DIVISION

Sketch of Service Here **3**

