

Name

Service No.

Address 4 Thoreau RD

Location

Kind of Pipe PVC

Size 6"

Size of Main 8"

Repair—Renewal—New Service

J. McLaughlin Tendon


Location

Date	Material	Amount	Total	Date	Amount
APRIL 04	3.5' 4" sch 40 PVC				
	105.6' 6" PVC				
1	6"-22 1/2" bend				
1	4x6 Fence				
1	6" PVC x 6" AG. Fence				
SEPT 68	29' 6" Transit pipe				
	Excavating				

DATE _____

TOWN OF LEXINGTON — BOARD OF PUBLIC WORKS
SEWER DIVISION

Sketch of Service Here

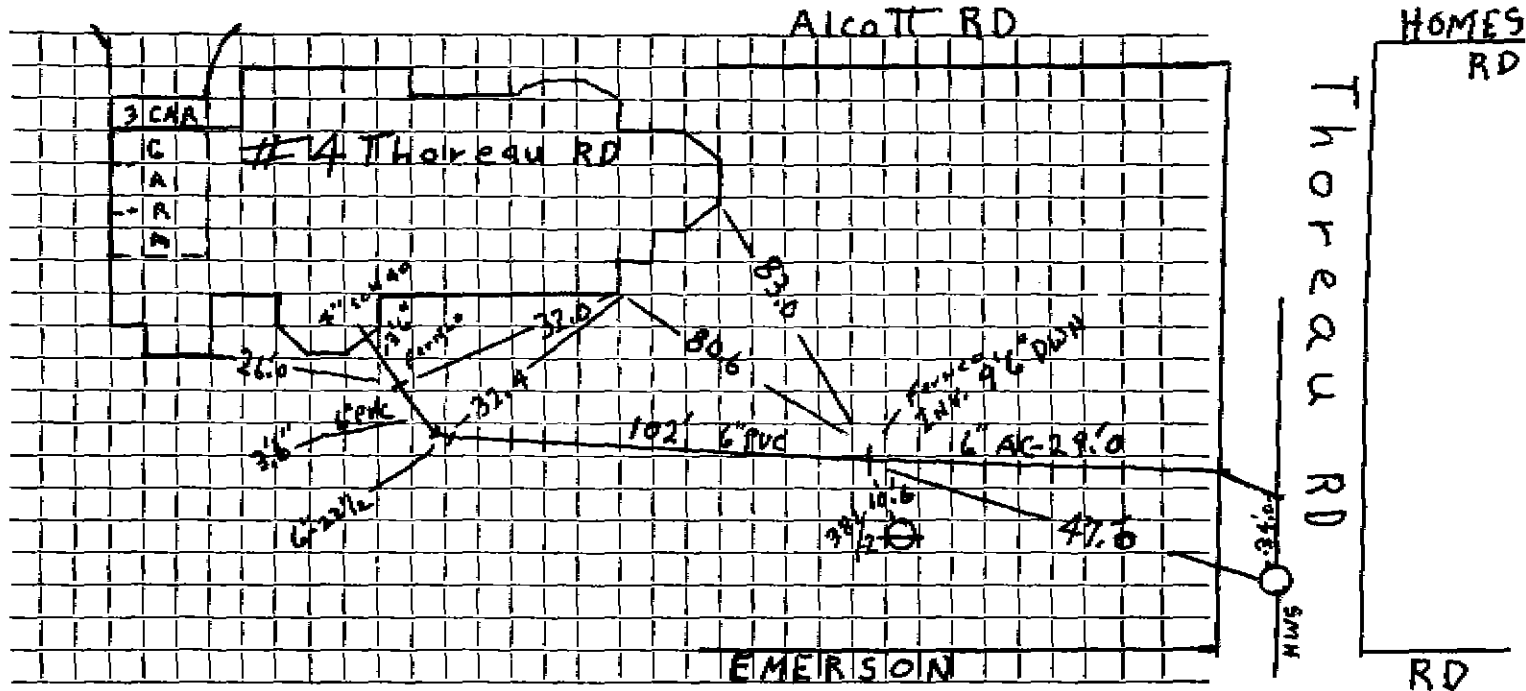

Connection made in Thoreau RD Street. Work completed April 2004

Remarks:

.....

.....