
TOWN OF LEXINGTON

Sewer Service Tie Card

MASSACHUSETTS

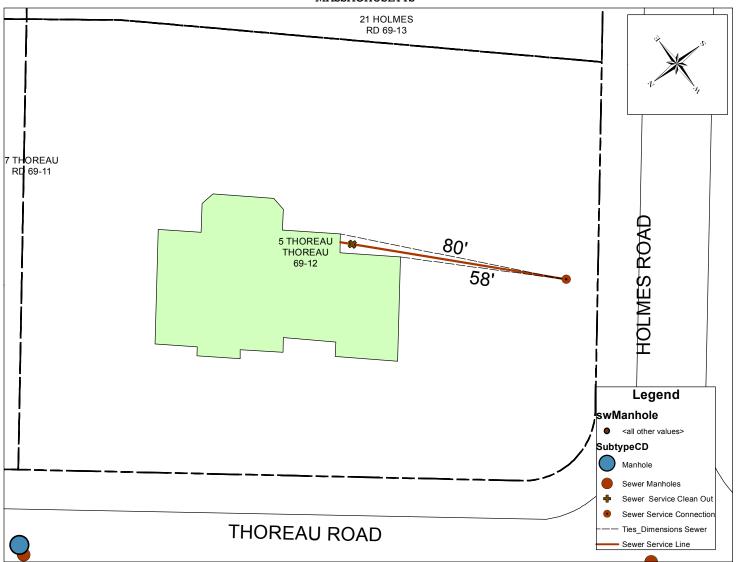

Address	Map and Lot	Permit Number	Contractor Name	Inspector
5 Thoreau Rd	69-12	6071	S&T Frotton, Inc.	msprague
Date	Material	Depth of Cover	Amount	
4/17/2014	6x6 VC to PVC Fern Co		1-Connect to existing stub	
	6 " PVC Pipe - SDR 35	5 ft	77 ft ft to CO	
				1
Type of work com	npleted			

New 6" PVC sewer service installed to new house, connection to existing stub.