

862-0681

Name Paul Hurney

Service No. 70

Address 6 Thoreau Road

6 Thoreau Road

Location

Kind of Pipe

Size 6"

Size of Main 8"

Repair—Renewal—New Service W. O. #9729


Location JUL 31 1972

Date	Material	Amount	Total	Date	Amount
5/26/72	Labor 118.62			5-23-72	500.00
6/23/72	" 70.28	188.90		8-7-7	135.27
	10% O.H.	18.89	207.80		200.00
10'	6" Transite pipe @.90		9.00		
2	5' x 6" Nipple @.89		8.90		
1	22 1/2° Sweep		6.83		
1/2	Bag Cement @1.98		.99		
3	ton Cold Patch @8.00		24.00		
3	ton Hot Top @8.00		24.00		
5	hrs. Trucking @3.00		15.00		
3 1/2	hrs. Town Shovel @6.50		22.75		
2	hrs. Loader @4.00		8.00		
1	hr. Compressor		5.00		
1/2	hr. Roller @2.00		1.00		
1	hr. Trailer @2.00		2.00		
			335.27		

DATE _____

TOWN OF LEXINGTON — BOARD OF PUBLIC WORKS
SEWER DIVISION

Sketch of Service Here ^{SMH} 6

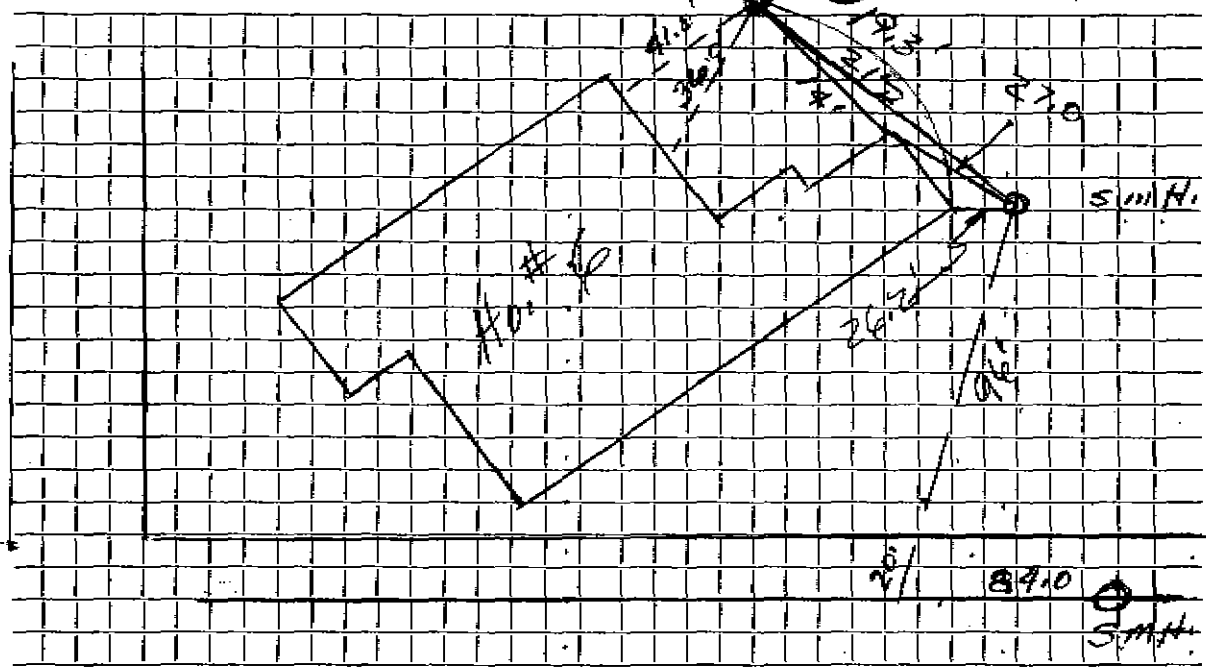

Connection made in Street. Work completed

Remarks:
.....
.....