


DATE _____

TOWN OF LEXINGTON — BOARD OF PUBLIC WORKS

SEWER DIVISION

Sketch of Service Here **8**

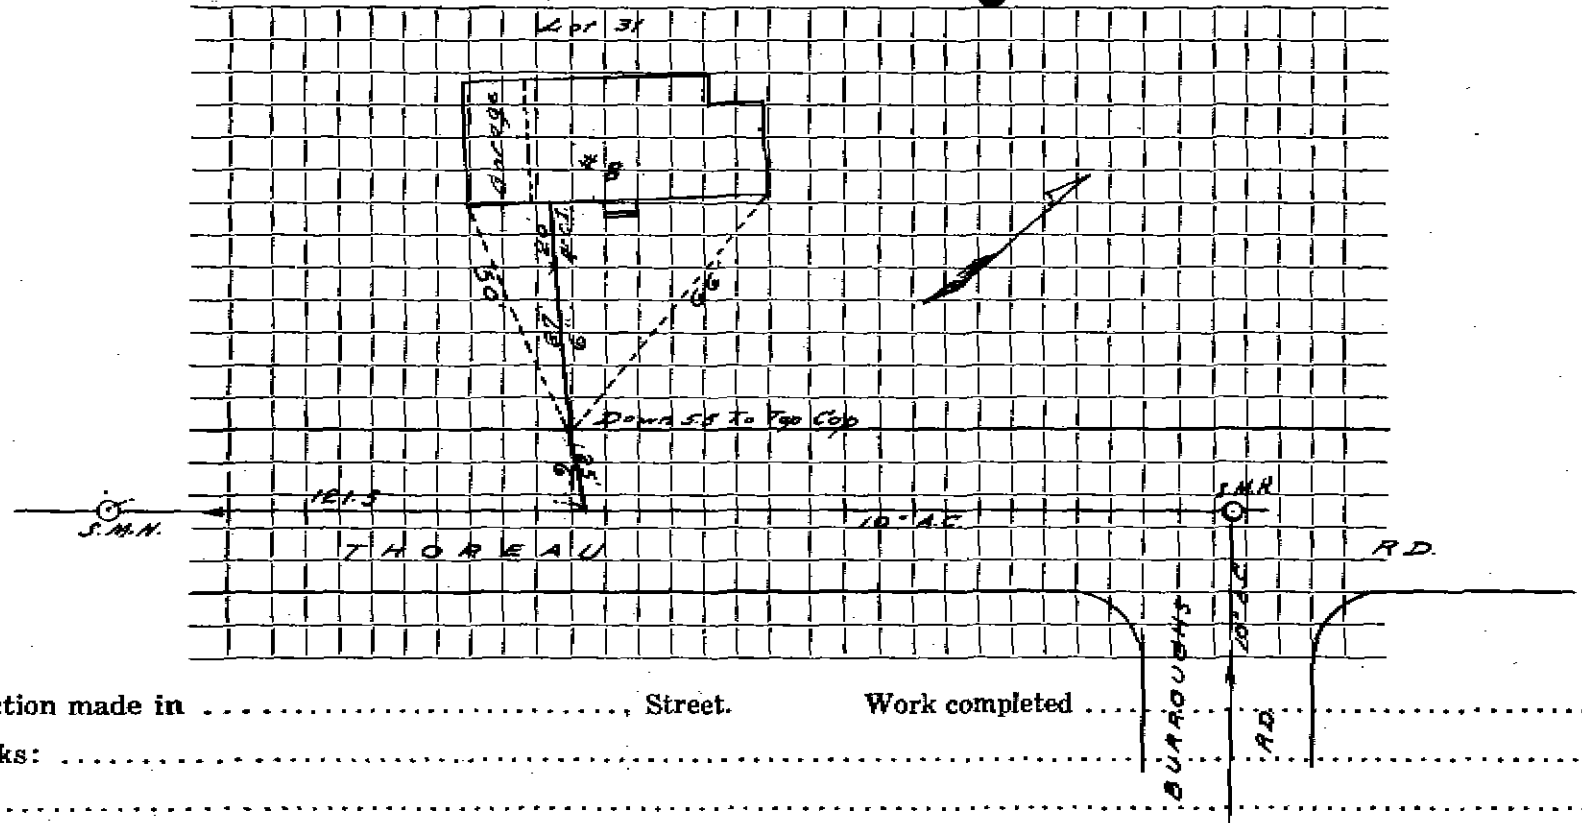

Connection made in Street. Work completed

Remarks:
.....
.....

Name **Jack Arnow**

Service Neg# 106

Address **8 Thoreau Road**

8 Thoreau Rd lot 31

lot 31

Location

Kind of Pipe

Size **6"**

Size of Main **8"**

Repair—Renewal—New Service Suburbanite #1219

Location **JAN 27 1969**

Date		Material	Amount	Total	Date	Amount
Sep '68	25'	6" Transite pipe @8.00		200.00	11-28-68	Deposit 200.00
10-29-68	27'	6" Transite pipe				
	20'	4" Cast Iron pipe				