


DATE

TOWN OF LEXINGTON — BOARD OF PUBLIC WORKS SEWER DIVISION

Sketch of Service Here **10**

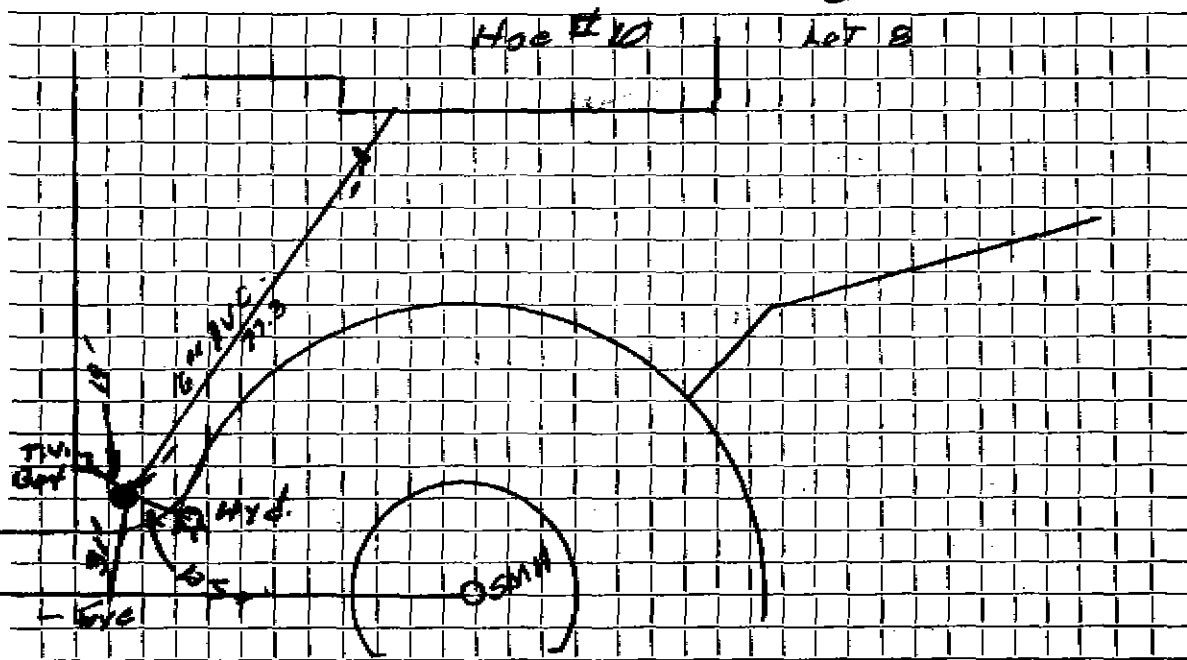

Connection made in Street. Work completed

Remarks: