

DATE _____


TOWN OF LEXINGTON — BOARD OF PUBLIC WORKS

SEWER DIVISION

Sketch of Service Here

2

LOT 12

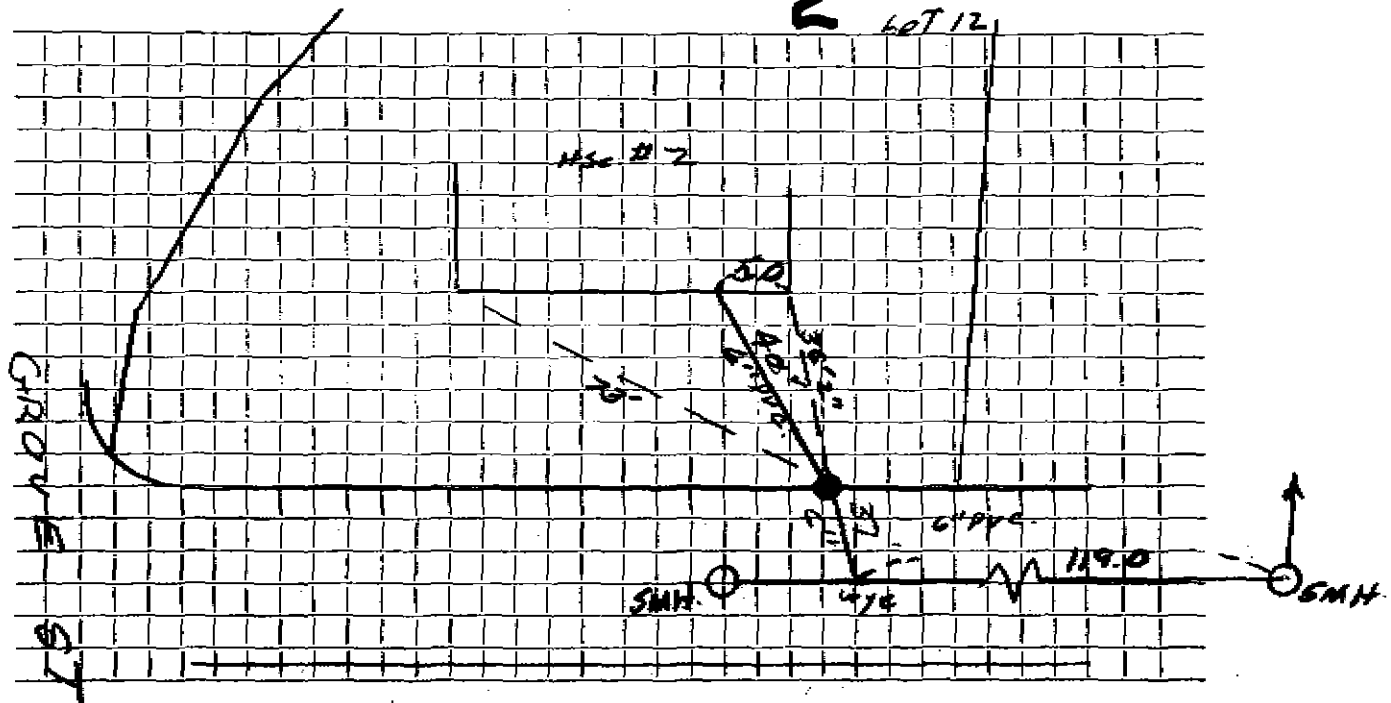

Connection made in TIDD CIRCLE Street. Work completed

Remarks:

.....