


DATE _____

TOWN OF LEXINGTON — BOARD OF PUBLIC WORKS

SEWER DIVISION

Sketch of Service Here

5

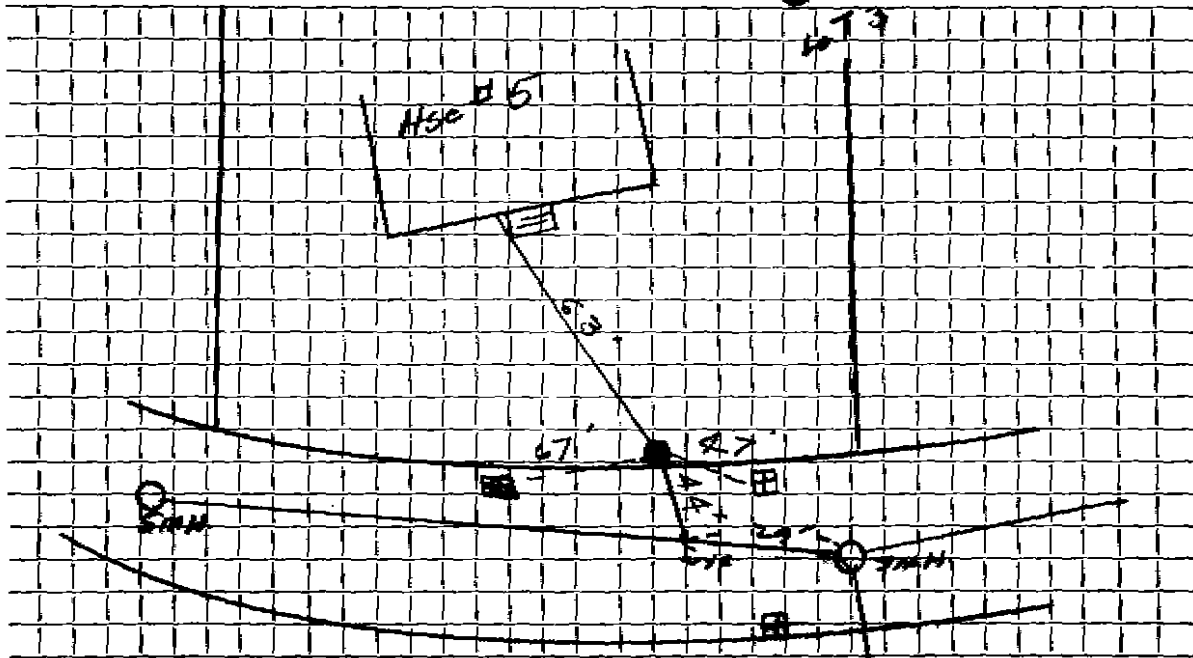

63

44

Connection made in Street. Work completed

Remarks:

.....

.....