

Name R. J. Foley Realty Trust

Service No.

127

Address 1 Todd Road

1 Todd Road

Location

Kind of Pipe

Size 6"

Size of Main 8"

~~Repair~~ New Service

W.O. #9103 DeFelice Bros - Permit #68

Location


Ann 9-21-64

Date	Material	Amount	Total	Date	Amount
8-19-64	Labor	69.54		8-6-64	150.00
	10% O.H.	6.95	76.49		
	20' 6" Transite pipe @.82		16.40		
	1 6 x 24 Saddle		7.50		
	1 90° Transite Elbow		4.09		
	1 1" Nipple		.52		
	19 x 3 Patch		19.00		
	2 hrs. Town Shovel @6.50		13.00		
	2 hrs. Trucking @3.00		6.00		
	1 hr. Loader @4.00		4.00		
	1 hr. Welder		3.00		
			150.00		
8-24-64	60' 6" Transite Pipe				

DATE _____

TOWN OF LEXINGTON — BOARD OF PUBLIC WORKS
SEWER DIVISION

Sketch of Service Here /

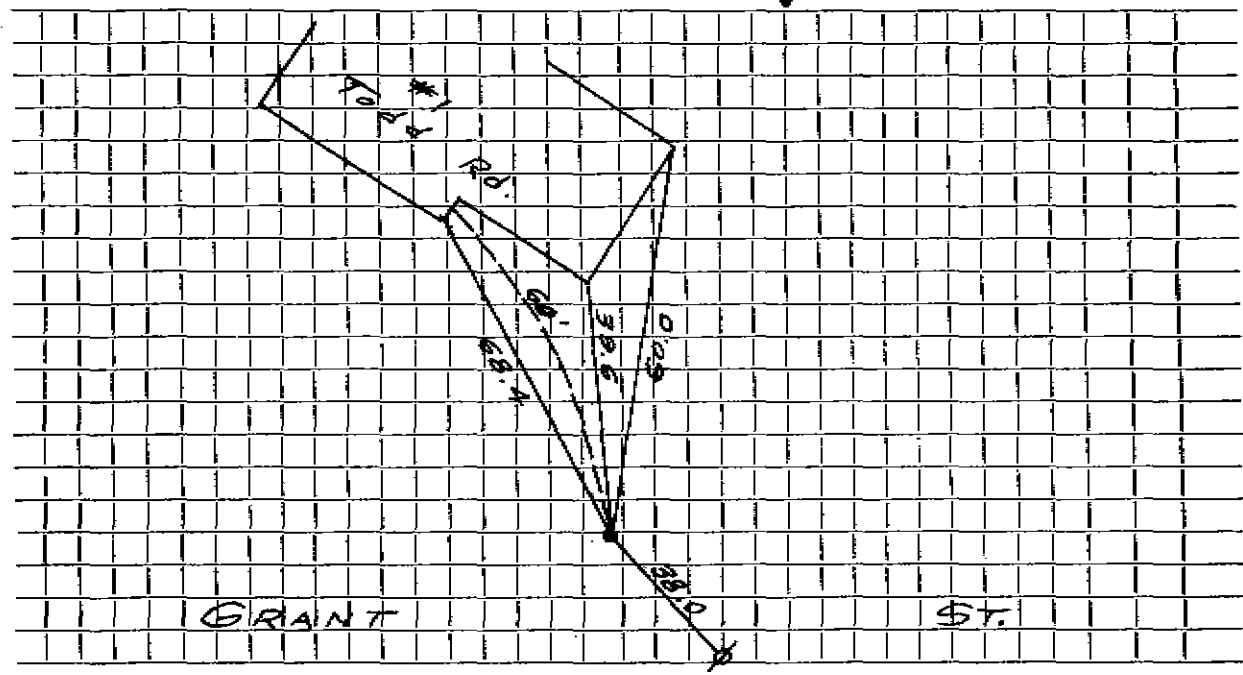

Connection made in Street. Work completed

Remarks:
.....
.....