

Name **Noore Realty Trust**

Service No. **367**

Address **10 Todd Road**

10 Todd Road

Location

Kind of Pipe

Size **6"**

Size of Main **8"**

~~Repair/Replacement~~ — **New Service**

Location **MAR 23 1964**


Date	Material	Amount	Total	Date	Amount
11-15-63	Labor	8 27		11-5-63	Deposit 100 00
	10% O.H.	83	9 10	3-35-64	* Retard 40 85
28	6" Transite Pipe @.82		22 96		39 15
1	11 1/4" Transite Bend		4 09		
1	Hr. Trucking @3.00		3 00		
			39 15		

* Apply 101 To SUC#1

DATE _____

TOWN OF LEXINGTON — BOARD OF PUBLIC WORKS
SEWER DIVISION

Sketch of Service Here **10**

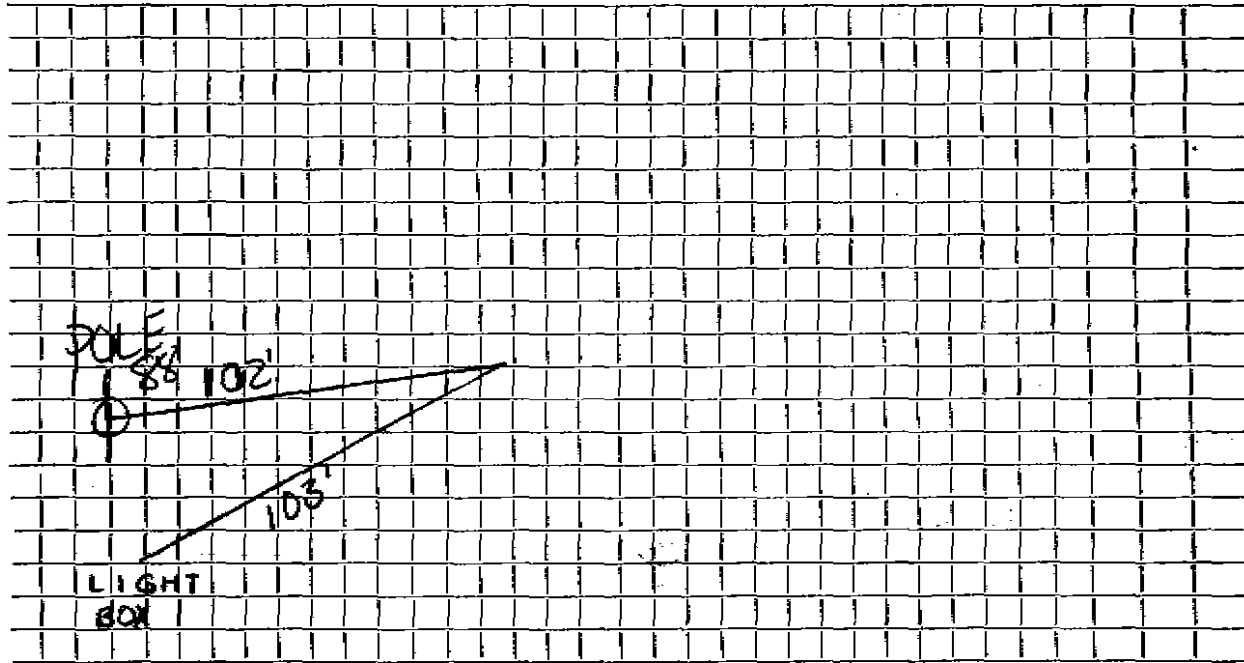

Connection made in Street. Work completed

Remarks:
.....
.....