

Name Donald Jenkins

Service No. 114

Address 7 Todd Road

Lot #25 Sta. 6+08 El. 181.08

Location

Kind of Pipe

Size 6"

Size of Main 8"

Repair—Renewal—New Service

WO # 7492

Location

Comm 10-29-62

Date	Material	Amount	Total	Date	Amount
6-25-62	Labor	17.97		9-27-62	Deposit 150.00
	10% O.H.	1.80	19.77	10-29-62	Refund 37.37
	26' 6" Transite pipe @.78		20.28		112.63
	1 11 1/4° Transite Elbow		2.35		
	1 6" Cap		1.93		
	BILL WHEN CONNECTED		44.33		
8-6-62	Labor	20.62			
	10% O.H.	2.06	22.67		
	47' 6" Transite pipe @82		38.54		
	1 11 1/4° Transite Bend		4.09		
	1 Hr. Trucking @3.00		3.00		
			112.63		


\* Apply 298 to WOC # 96

DATE \_\_\_\_\_

**TOWN OF LEXINGTON — BOARD OF PUBLIC WORKS**  
**SEWER DIVISION**

Sketch of Service Here

7

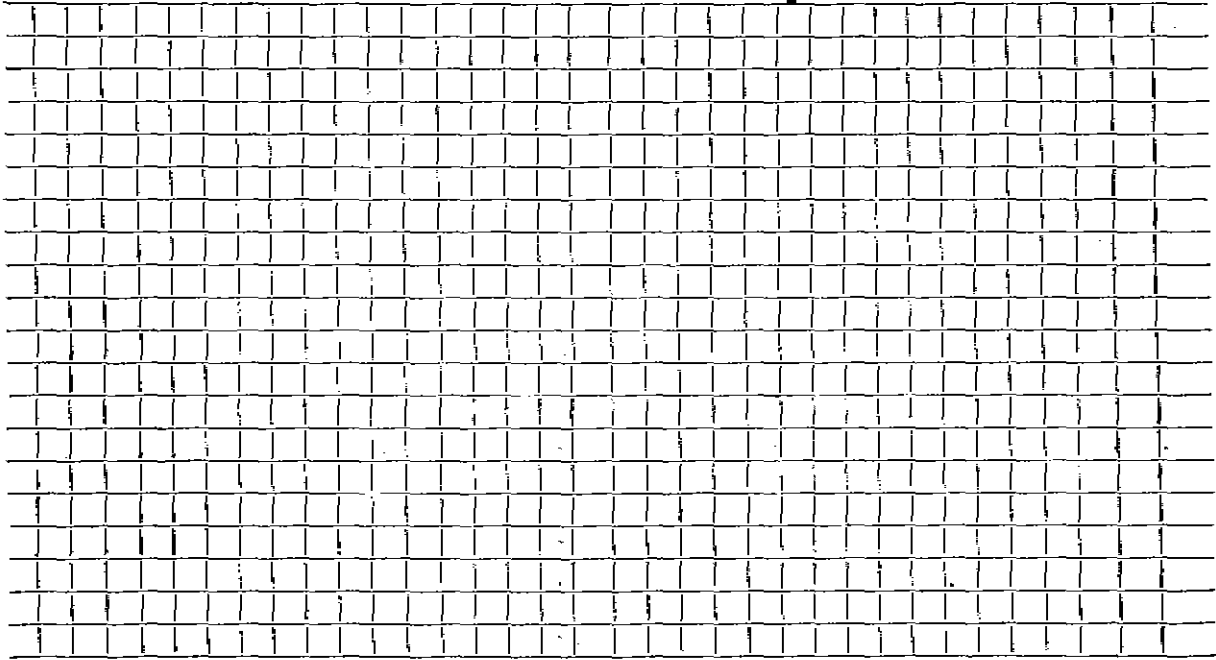

Connection made in ..... Street.      Work completed .....

Remarks: .....  
.....  
.....