



TOWN OF LEXINGTON—BOARD OF PUBLIC WORKS.  
SEWER DIVISION

DATE November 13, 1931

NO. \_\_\_\_\_


The undersigned applies for the construction of a particular sewer connecting No. Tower St.  
Street and hereby agrees to comply with the Rules and Regulations governing the construction and use of Particular  
Sewers, as now or at any future time established by the Board of Selectmen.

Am't. of Estimate \$ \_\_\_\_\_

Am't. Paid \$ \_\_\_\_\_

*Lincoln C & Ayana Gunk* Owner  
*Tower Street Lexington*

Sketch of Service Here

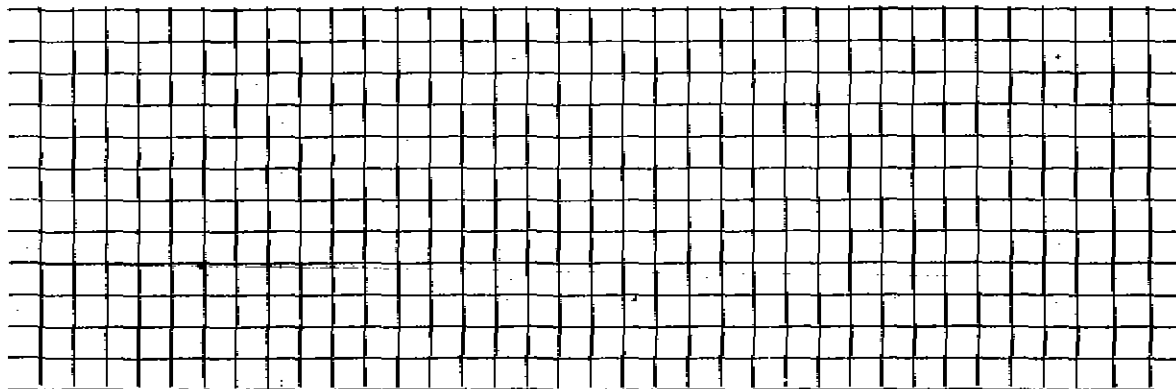

Connection made in \_\_\_\_\_ Street. Work completed \_\_\_\_\_ 19

Remarks:

Name John W. Bullock Realty Const.

Service No. 22

Address 11 Tower Road

11 Tower Road

Location

Kind of Pipe

Size 6"

Size of Main 8"

~~Repair Work~~ New Service W.O. #7834

Location Quinn 6-3-63


Date	Material	Amount	Total	Date	Amount
4-29-63	Labor	82.88		4-16-63	Deposit 250.00
	10% O.H.	8.29	91.17	6-3-63	Refund 76.00
	57' 6" Transite Pipe @.82		46.74		174.00
	1 90° Transite Elbow		4.09		
	4 hrs Town Shovel @6.50		26.00		
	2 hrs. Trucking @3.00		6.00		
			174.00		

DATE \_\_\_\_\_

TOWN OF LEXINGTON — BOARD OF PUBLIC WORKS

SEWER DIVISION

Sketch of Service Here //

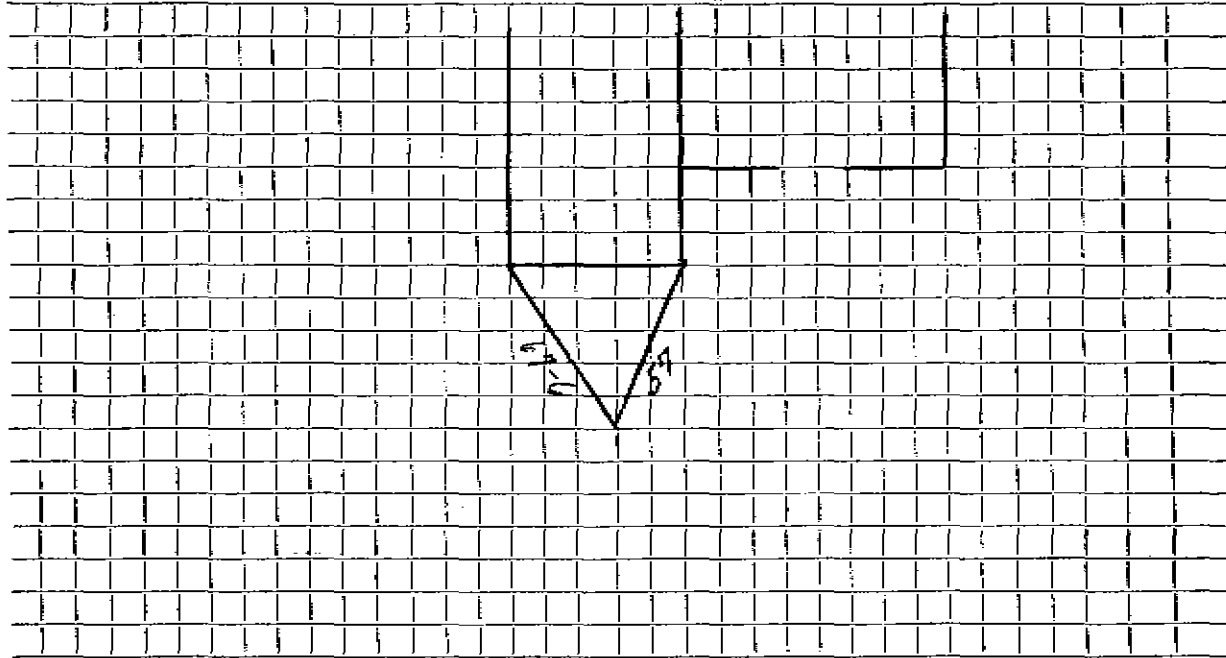

Connection made in ..... Street. Work completed .....

Remarks: .....  
.....  
.....