

Customer Bros.  
 54 Bedford St.

Service No. 6

Address: 10 Tower St. #12  
 Location: Lot #57, Tower St.

Kind of Pipe: **Business Renewal - New Service**  
 Size: **6"**      Size of Main: **8"**

Date	Material	Amount	Total	Date	Amount
1/21/32	63' 1/2" Sewer Pipe @ .15	\$9.45		July 21, 1934	Coach -
1/21/32	1 1/8" Bend	70			
	Sulphur & Jute	2.52			
	Trucking	75	\$13.42		
7	Hrs. Labor @ .55	3.85		Aug 4-2-33	
2	" @ .60	1.20		Aug 3-2-34	
2	" @ .55	1.00	6.05		
	15% Overhead		91		
			20.39		
	Labor			5298	Roots 8' 12' 22' 36' 53'
				12-13-65	Parts Respond
					Service can be finished from main

TOWN OF LEXINGTON—BOARD OF PUBLIC WORKS

SEWER DIVISION

DATE April 13-32


The undersigned applies for the construction of a particular sewer connecting No. 571 Over St.  
April 13-32  
Street and hereby agrees to comply with the Rules and Regulations governing the construction and use of Particular Sewers, as now or at any future time established by the Board of Selectmen.

Am't. of Estimate \$ \_\_\_\_\_

Am't. Paid \$ \_\_\_\_\_

Theodore A. Custard Owner

Sketch of Service Here

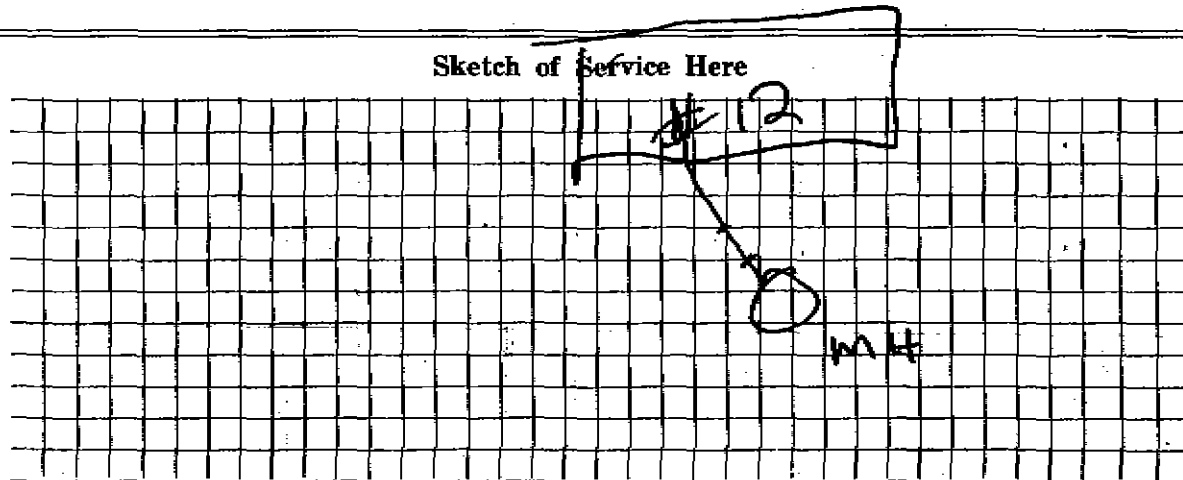

Connection made in \_\_\_\_\_ Street. Work completed \_\_\_\_\_ 19

Remarks: SERVICE REPAIRED Aug 18, 1998 14' of 6" PVC  
two 6" clay to 6" PVC French