

Name **Herbert McConchie**Service No. **47**Address **14 Tower Road****14 Tower Road**

Location

Kind of Pipe

Size **6"**Size of Main **8"**

Repair—Renewal—New Service

Comm: **9-24-56**

Location

Date	Material	Amount	Total	Date	Amount	
5/7/56	Labor	43 37		5-3-56	Deposit	\$ 200 00
	10% overhead	4 34	47 71	7-24-56	Refund	49 10
	50' 6" Sewer Pipe @	36 45	18 23			150 90
	Joint Compound		3 00			
	1 6" Elbow		1 88			
	9 1/3 hrs. Littlefield @ 8.50		79 33			
	1 hr. trucking @ .75		75			
			150 90			
	Redmond #4978					
7/13/87	39' 6" PVC					
	1 6" Wye					
	1 6" Wye Cleanout					
	2 1 1/2 6" PVC to Clay Fernco					
	4" x 6" Fernco					
	1 6" 22° Bend					
	4" PVC pipe					

TOWN OF LEXINGTON—DEPT. OF PUBLIC WORKS

SEWER DIVISION

DATE.....

NO.....


The undersigned applies for the construction of a particular sewer connecting No.....
 Street and hereby agrees to comply with the Rules and Regulations governing the construction and use of Particular
 Sewers, as now or at any future time established by the Board of Selectmen.

Am't of estimate \$.....

Am't Paid \$.....

..... Owner

Sketch of Service Here **14**

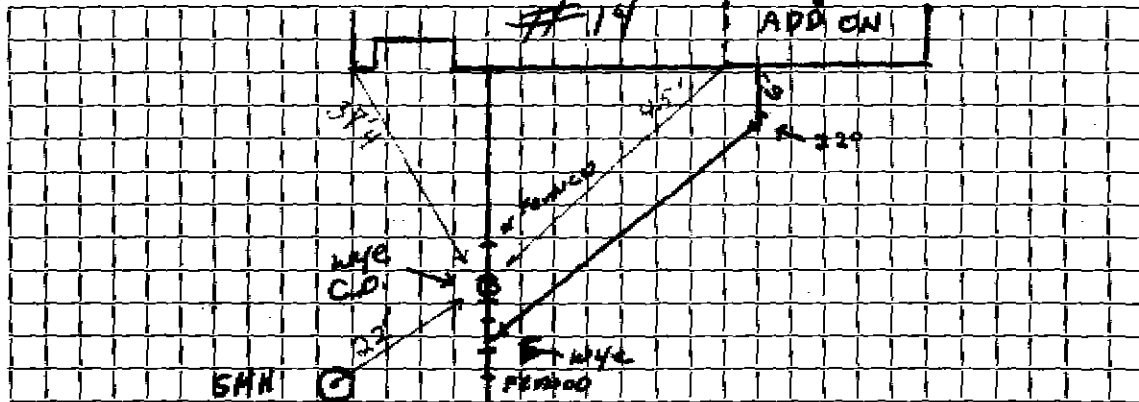

Connection made in..... Street.

Work completed..... 19..

Remarks: